


P-41218  
57745

T.13S., R.28E., W.M.

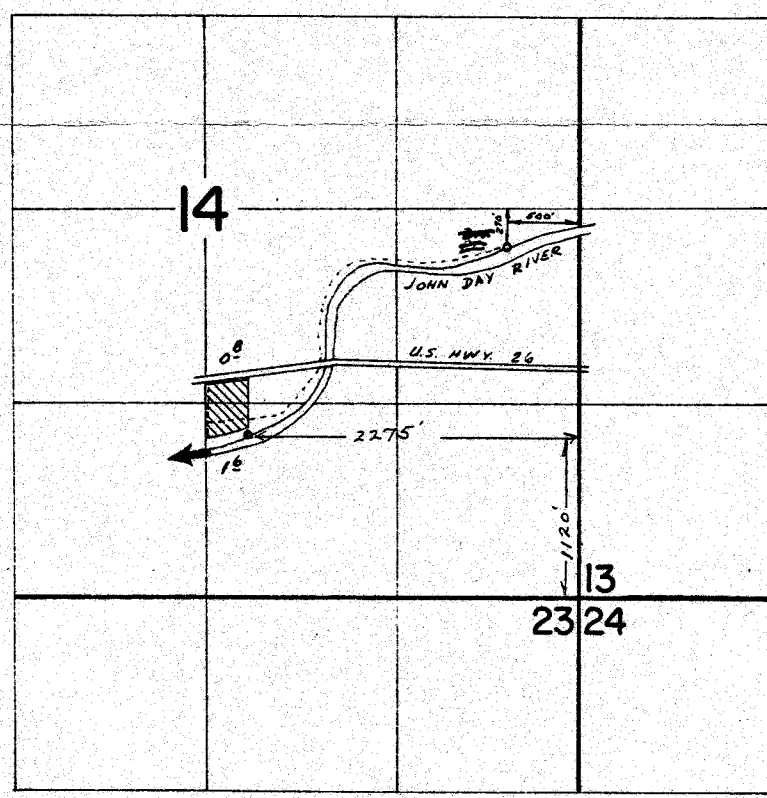

Application No. 55022

Permit No. 41218

Application map

~~FINAL PROOF SURVEY~~  
UNDER

RECEIVED

DEC 13 1976

WATER RESOURCES DEPT  
SALEM, OREGON

Application No. 46798 Permit No. 34998  
IN NAME OF

ROBERT D. ASHER

Surveyed June 21, 1975, by D. Norby

Watermaster, Dist. #4  
assisted with this application