# T.14S.,R.31E.,W.M.

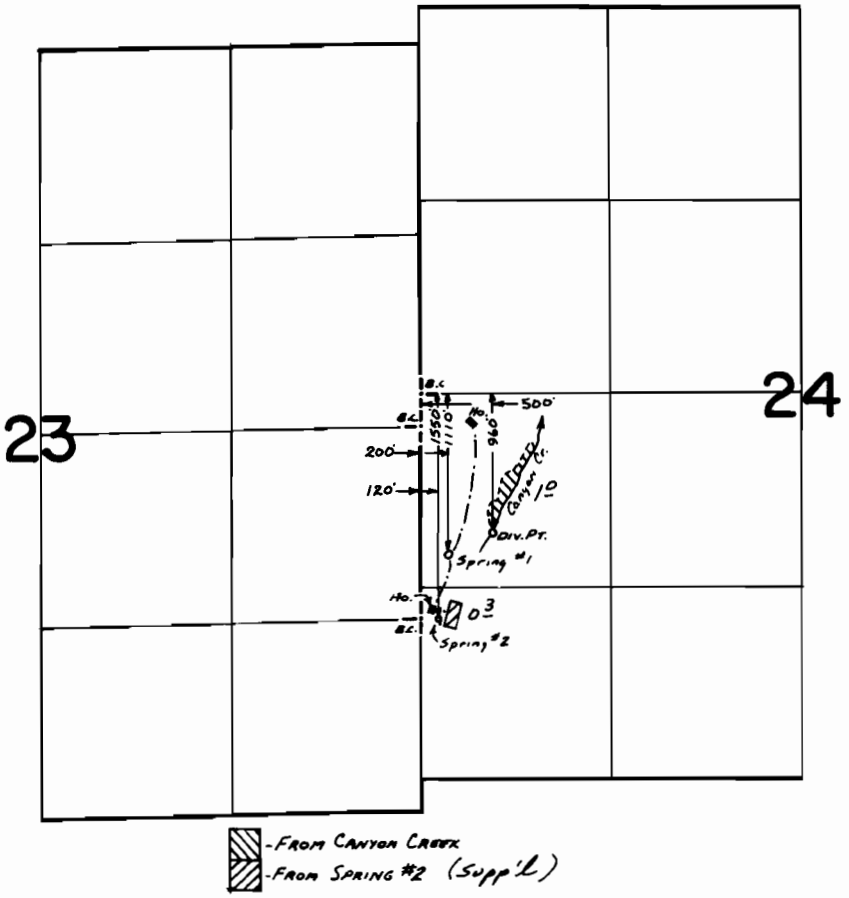


# FINAL PROOF SURVEY

UNDER

Application No. 59719 Permit No. 44818

IN NAME OF

ARTHUR R. & DEBRA J. THUNELL

& GEORGE LOGAN

Surveyed June 22 19.83., by R. W. Cettel

July 12 1983 R. W. Cettel

PTS 4-1983-A