


T.17S.,R.6W.,W.M.

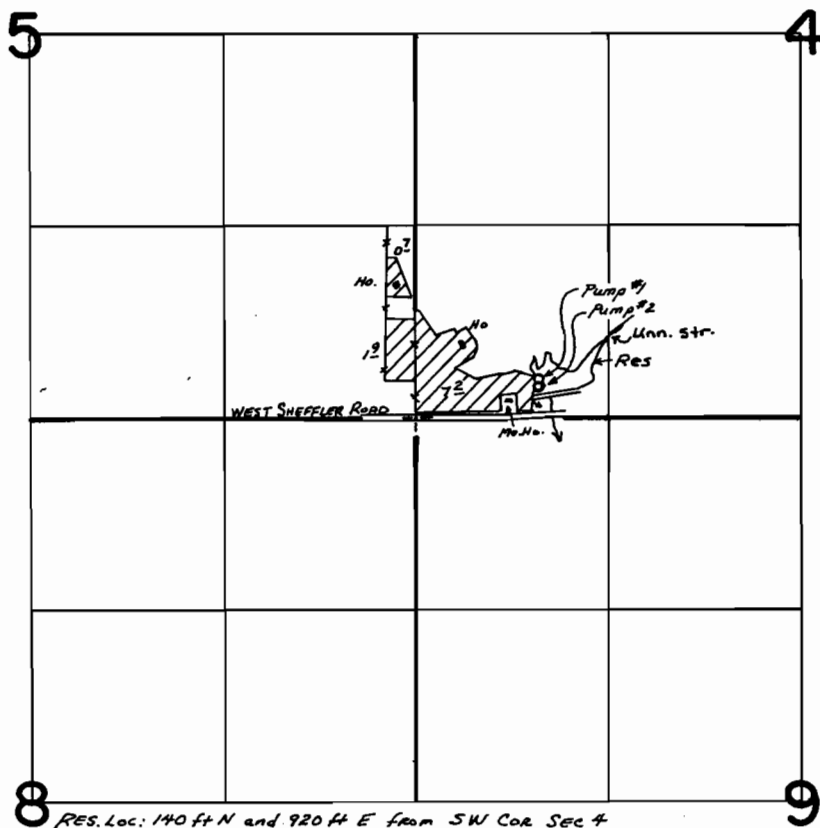

FINAL PROOF SURVEY
UNDER

Application No. 54552 41789
R-55114 Permit No. R-6611.....
IN NAME OF

.....BESSIE BOBIER.....

Surveyed May...5... 1982., by L.M. IOLL.....