


# T. 33S., R. 7W., W.M.

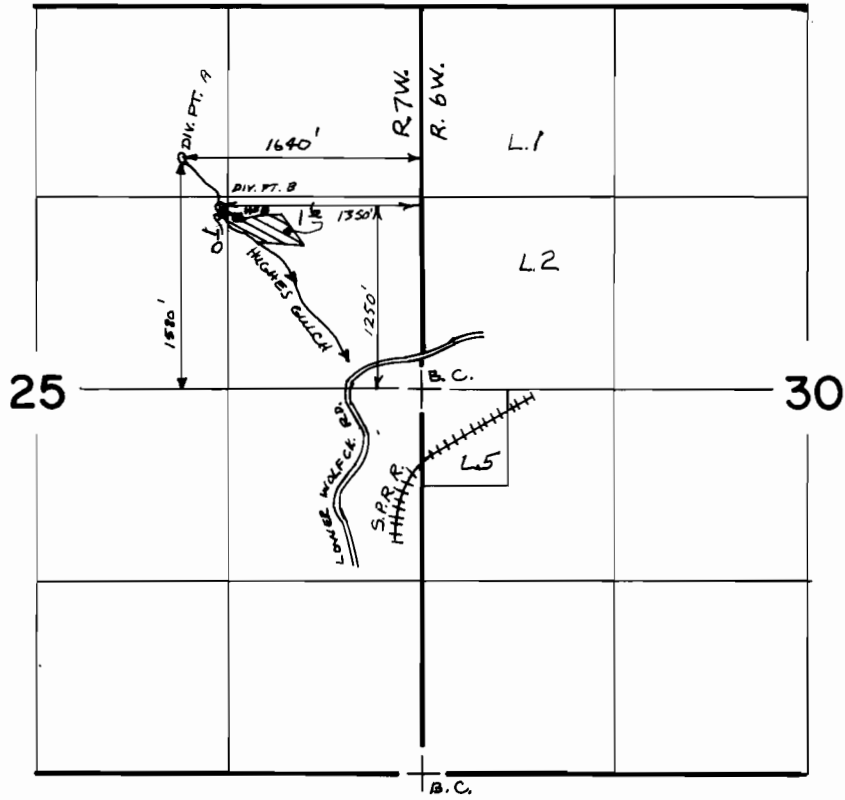

SCALE: 1"=1320'

## FINAL PROOF SURVEY UNDER

Application No. 537.51..... Permit No. 4036.6....  
IN NAME OF

**CALVIN RAY BUCHOLZ**

Surveyed SEPT. 25 84 by J. WOODROOF  
..... 19....., by .....