


T.26S., R.4W., W.M.

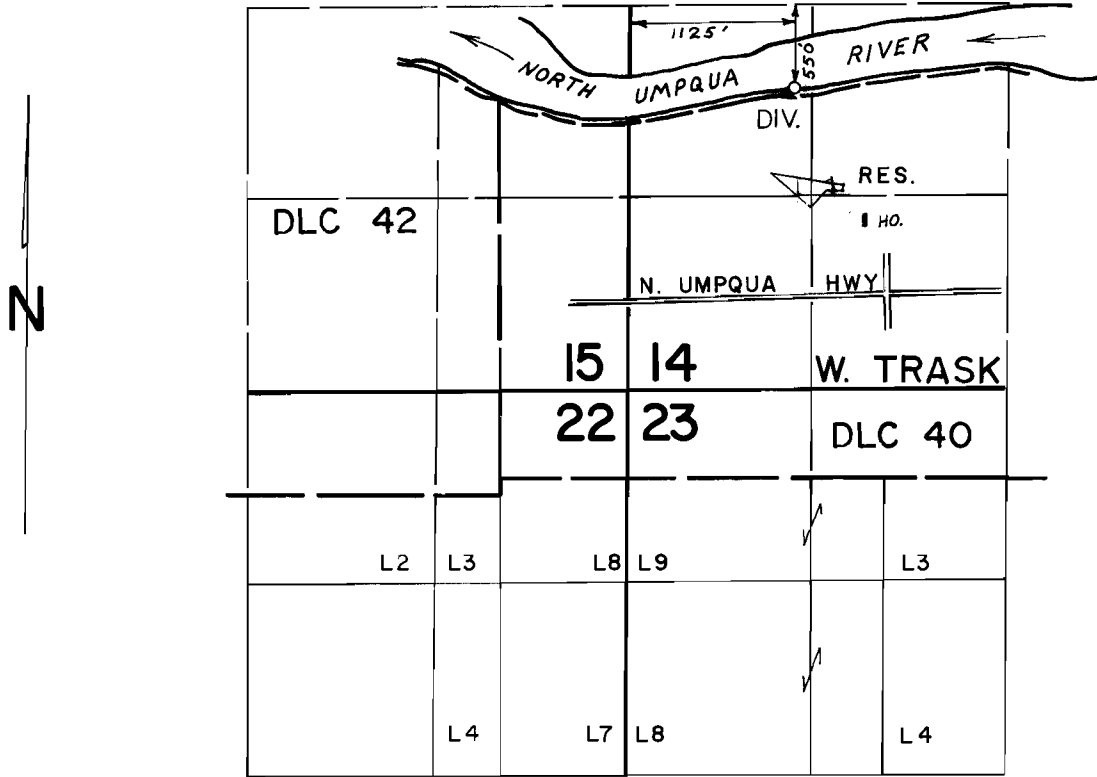

SCALE: 4" = 1 mile

FINAL PROOF SURVEY
UNDER

T - 5334

Application No. R-65481. Permit No. R-8888....
IN NAME OF

RICHARD CADDOCK

Surveyed AUG. 29, 19.84, by *J. Cashion*.....
30