



T. 36 S., R. 2 E., W.M.

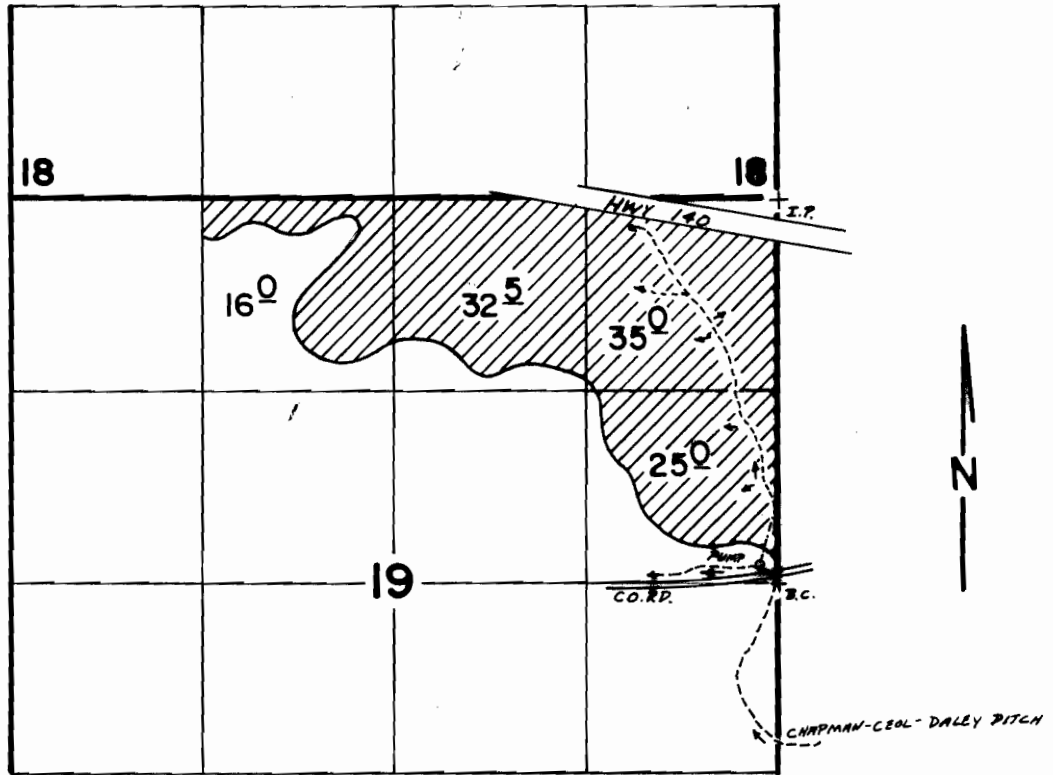

T. 36 S., R. 2 E., W.M.

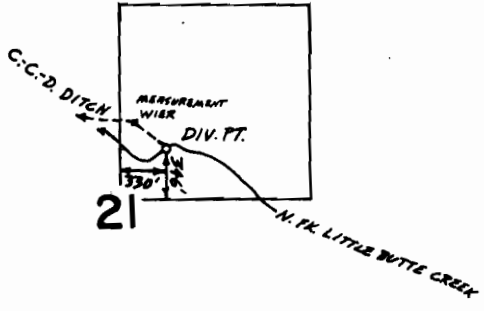

Scale 4" = 1 Mile

FINAL PROOF SURVEY
UNDER

Application No. 43210 Permit No. 33060
IN NAME OF

RUSSMAR COMPANY

Surveyed May 15, 1984, by B.S. JAMES