


T.17S., R.3W., W.M.

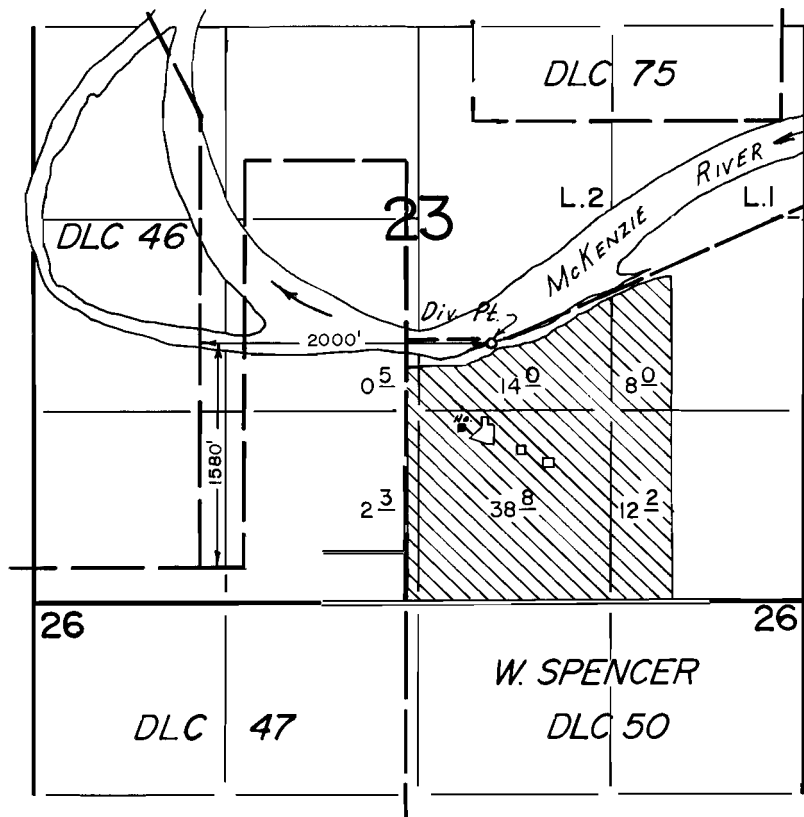

**FINAL PROOF SURVEY**  
UNDER

Application No. 55855... Permit No. 41902.....  
IN NAME OF

RODNEY W. & CHESTER A. CHASE

Surveyed MAY 8..... 19.80., by B.W. BISHOP.....