


T.41S., R.13W., W.M.

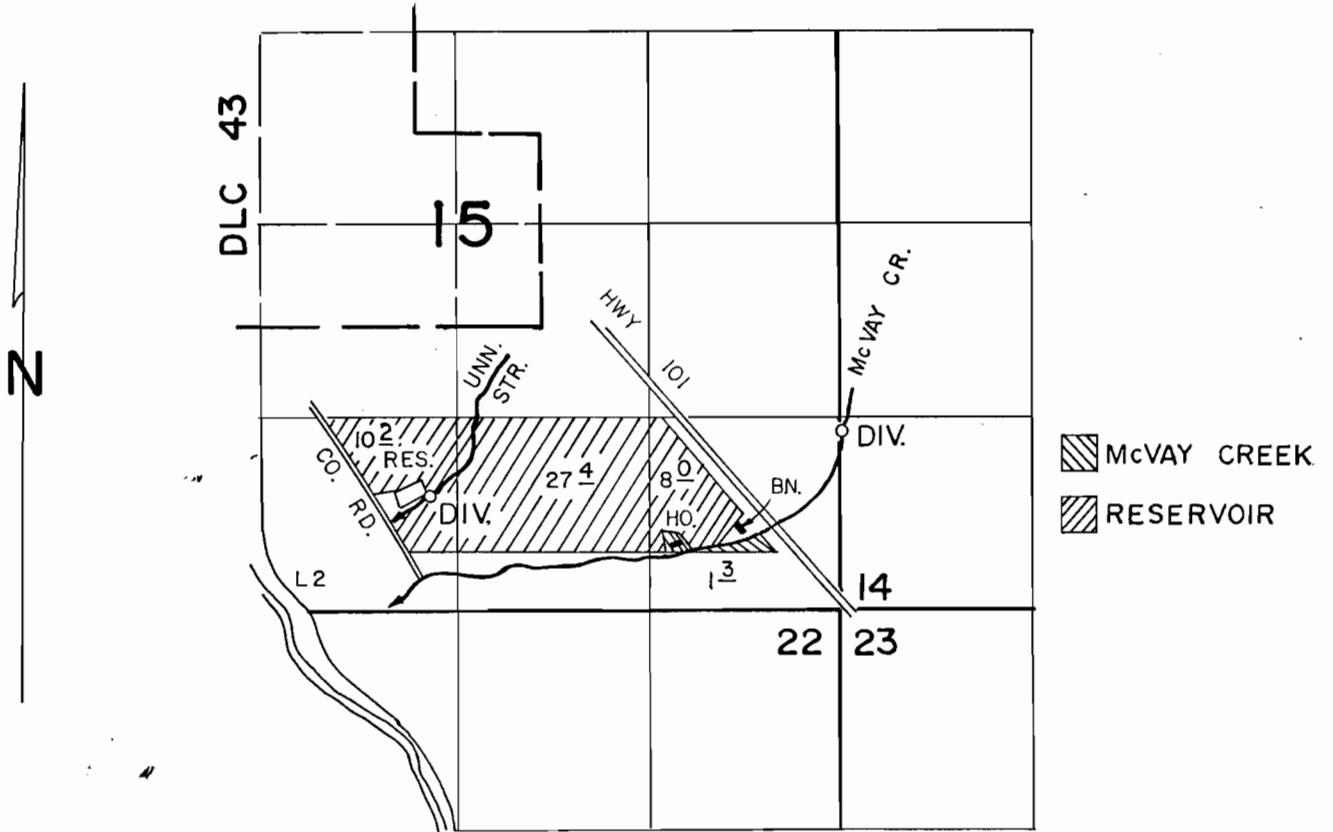

McVAY CREEK DIV. LOC. 1280'N. & 40'E. FROM SW CORNER SEC. 14
RES. DIV. LOC. 550'S. & 190'W. FROM CS 1/16 COR. SEC 15

FINAL PROOF SURVEY
UNDER

R-57439 R-8104
Application No. ...57440. Permit No. ...44754....
IN NAME OF

CAROL L. CROCKETT

Surveyed APR. 11, 1985, by *J.E. Cashin*