


T.41S., R.13W., W.M.

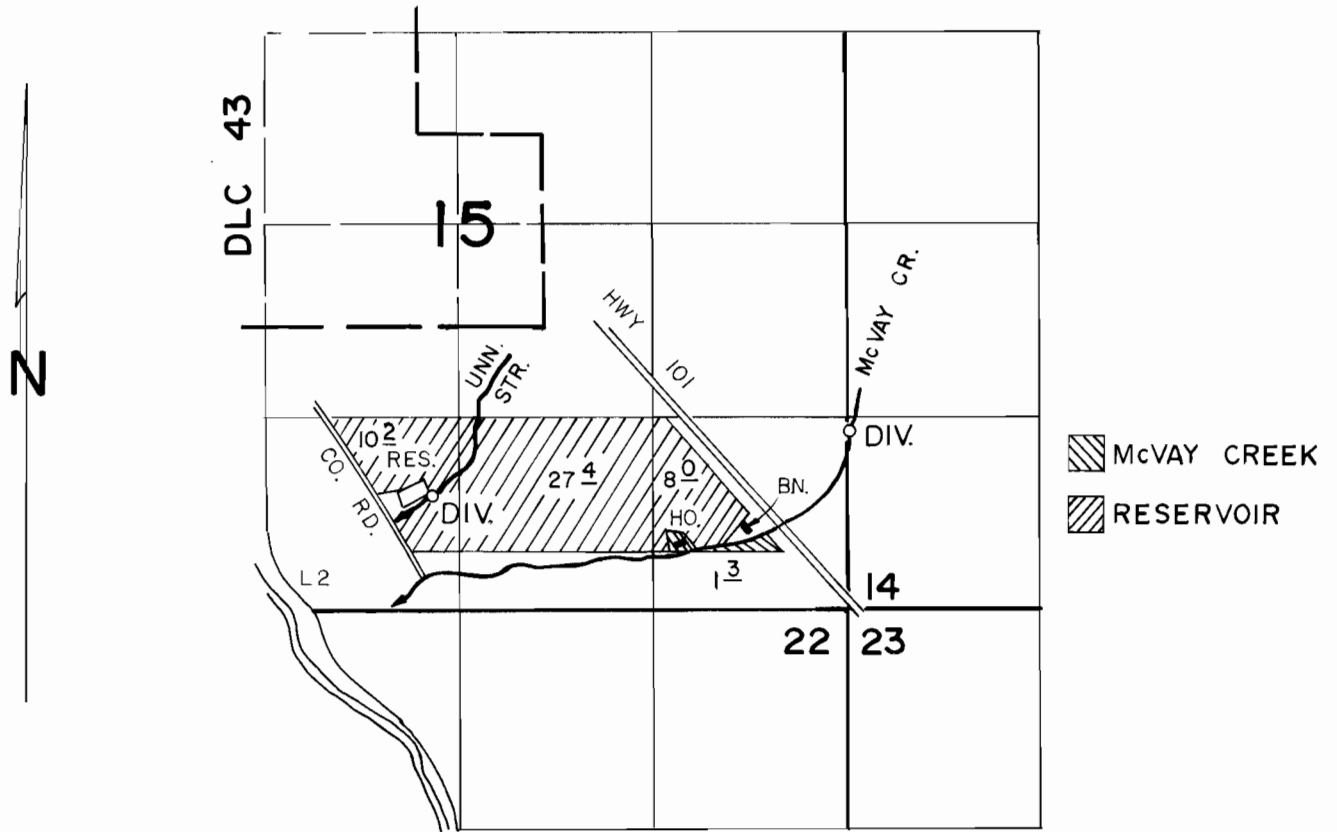

McVAY CREEK DIV. LOC. 1280'N. & 40'E. FROM SW CORNER SEC. 14  
 RES. DIV. LOC. 550'S. & 190'W. FROM CS 1/16 COR. SEC 15

**FINAL PROOF SURVEY**  
 UNDER

R- 57439                      R- 8104  
 Application No. 57440 Permit No. 44754  
 IN NAME OF

CAROL L. CROCKETT

Surveyed APR. 11, 1985, by J.E. Cushman