


T. 23 S., R. 33 E., W.M.

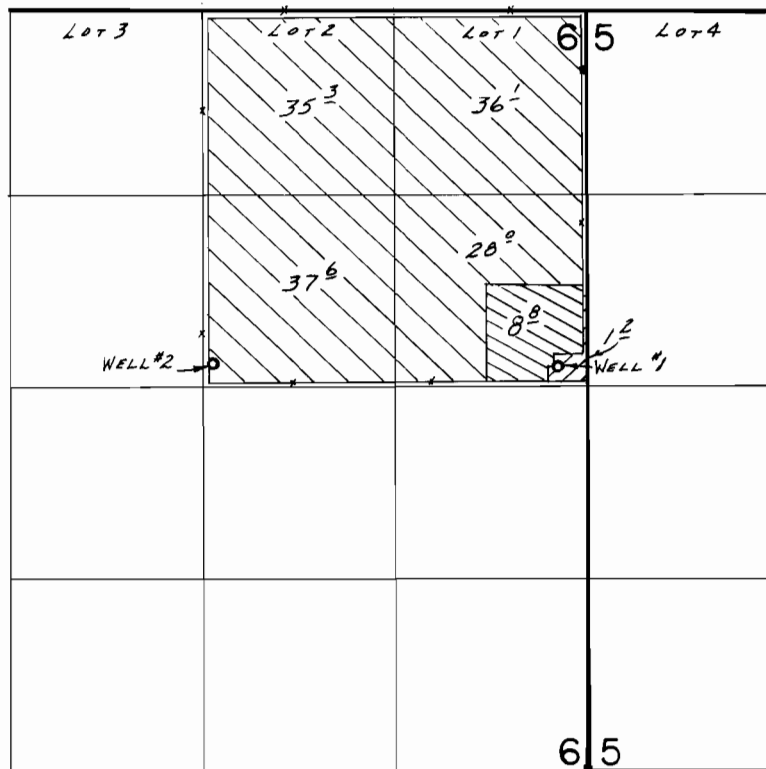

SCALE: 1" = 1320'

WELLS LOC.: #1- 140' N. & 2430' E., #2- 160' N. & 60' E., BOTH FROM
THE CENTER 1/4 CORNER OF SECTION 6.

 WELL 1 } PER. G-6674
  WELL 2 PER. G-7919
 WELL 2 }

FINAL PROOF SURVEY

UNDER

Application No. G-6838 G-6674
 G-8565 Permit No. G-7919
 IN NAME OF

CLAY FOX

Surveyed JULY 15, 1986, by V.L. CHURCH

12/17/87 BWS
41025-179-34R