


T.16S.,R.4W.,W.M.

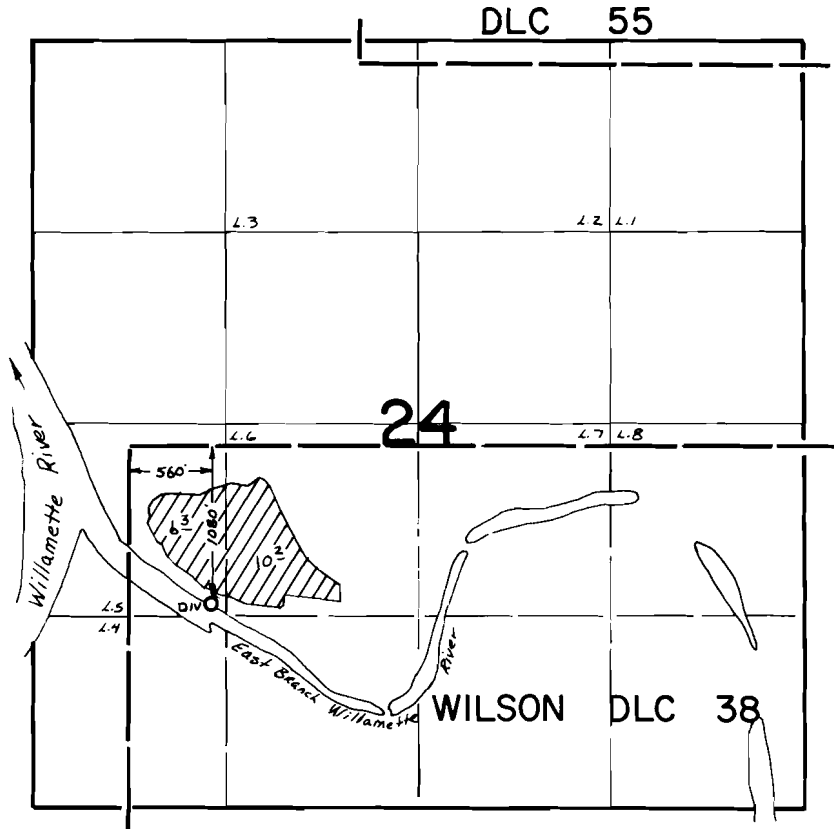

FINAL PROOF SURVEY
UNDER

Application No. 55755... Permit No. 41752.....
IN NAME OF

.....MRS. EDWARD E. DEGNER.....

Surveyed June 16... 1982., by L.M.TOLL.....