


T.8S.,R.11W.,W.M.

SECTION 36

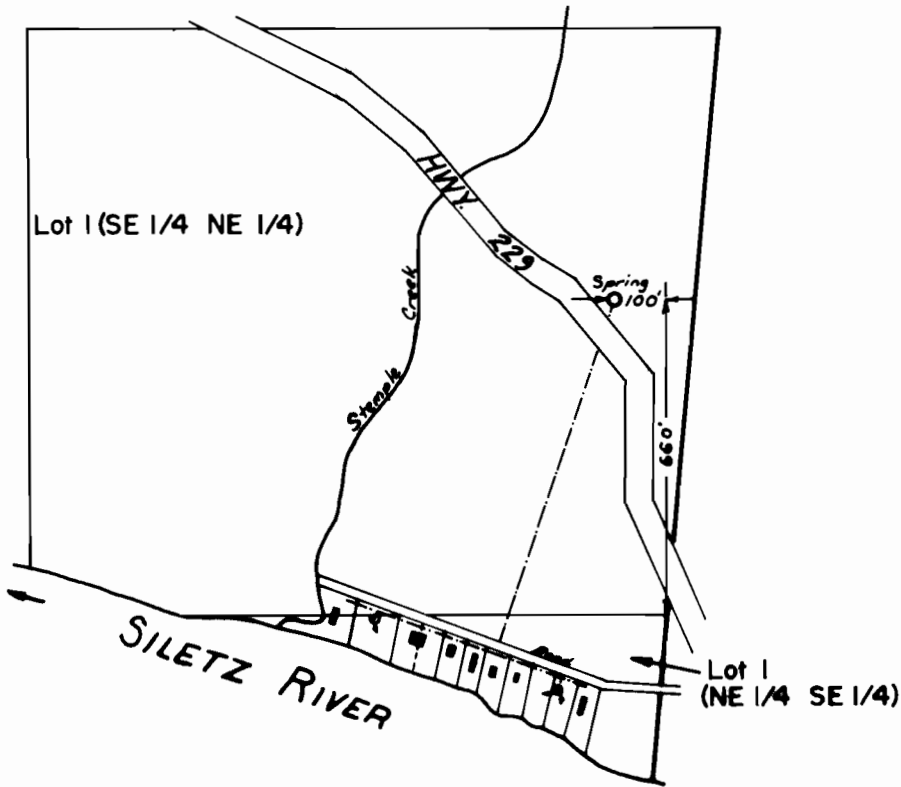

- - Dwelling
- - Standpipe

SCALE: 1" = 400'

FINAL PROOF SURVEY UNDER

Application No. .55126.. Permit No. .41334.....
IN NAME OF

.....H. R. DESELMs.....

Surveyed .Oct. 22.. 19.81., by .S. C. BROWN.....