


T7S.
R5W.
WM.

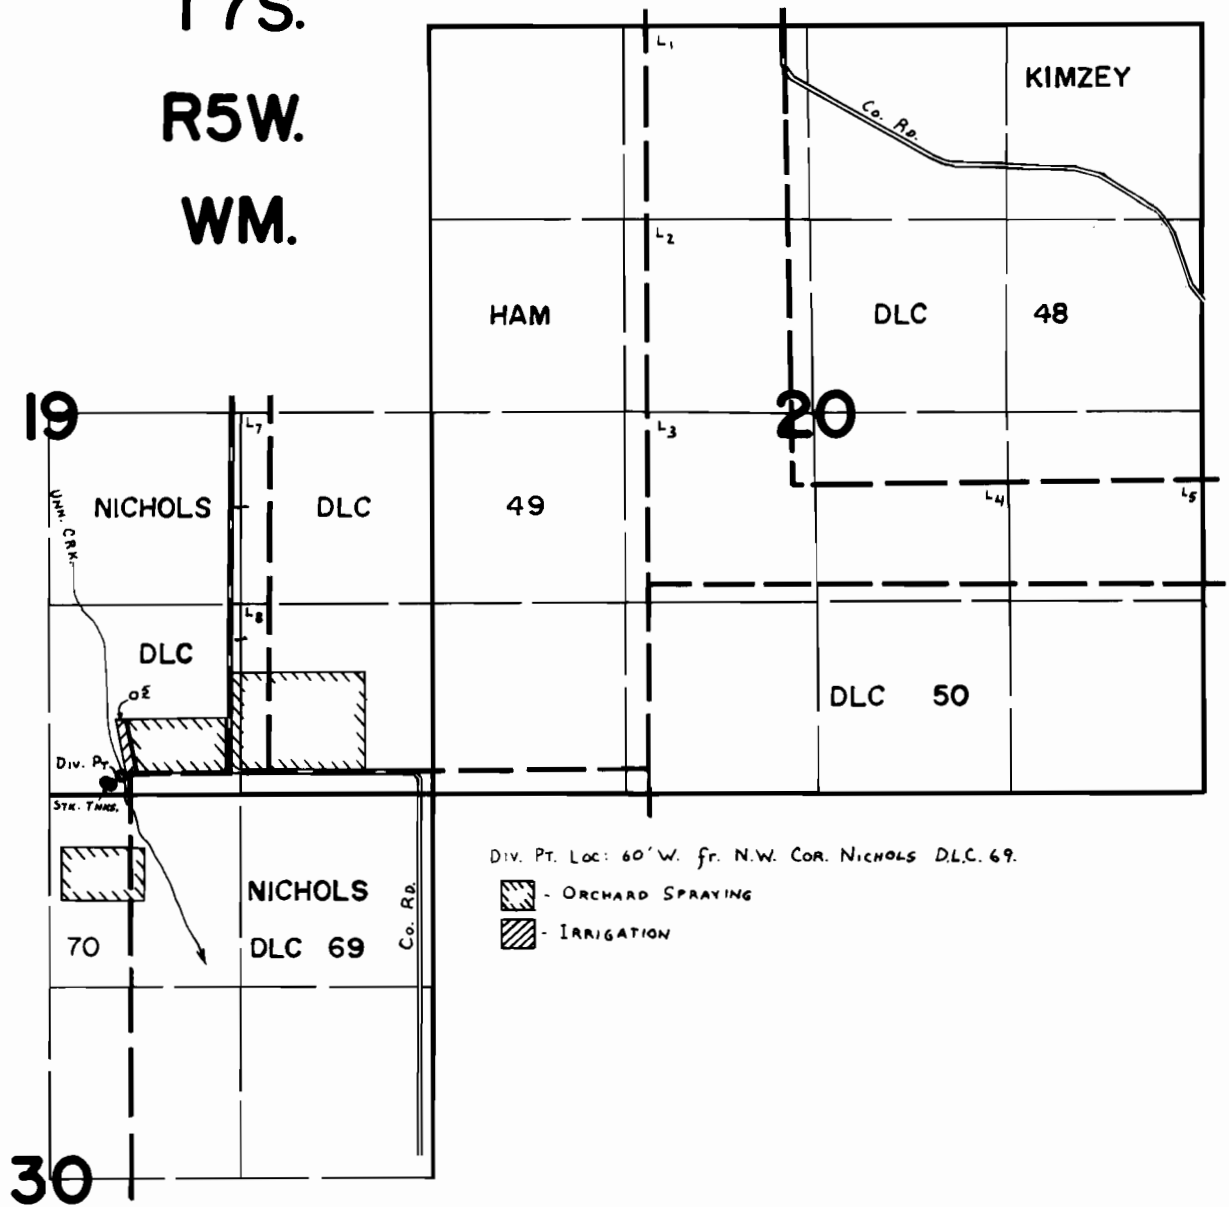

FINAL PROOF SURVEY
UNDER

Application No. .52915... Permit No. .39958.....
IN NAME OF

BUD & KATHRYN M. DOUGLAS

Surveyed June...7... 19.79., by .C.L. HUGHES.....