


T. 35 S., R. 4 W., W. M.

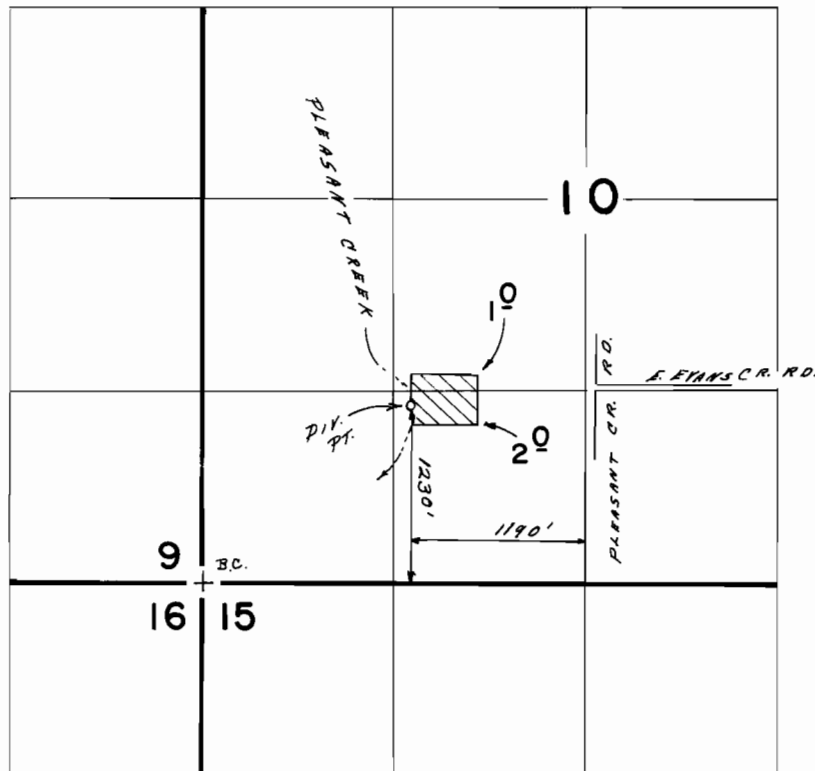

Scale: 1" = 1320'

FINAL PROOF SURVEY
UNDER

Application No. 54977 Permit No. 41258
IN NAME OF

EVANS VALLEY ELEMENTARY SCHOOL

Surveyed MAR. 20 1986, by B. S. JAMES...