


T.14S. R.9W. W.M.

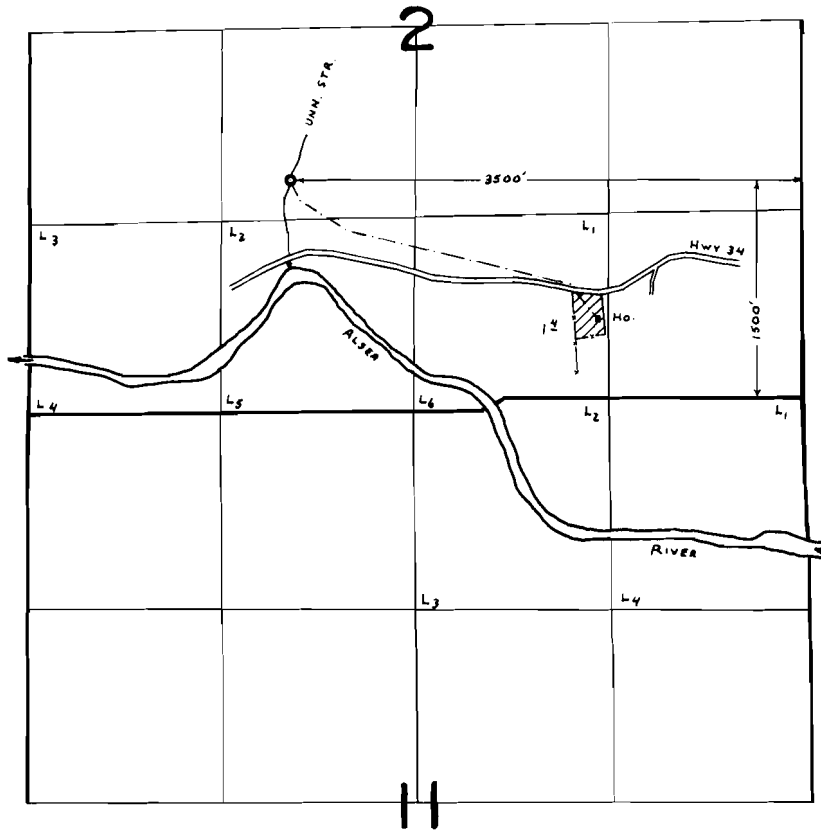

**FINAL PROOF SURVEY**  
UNDER

Application No. 55368.. Permit No. 41800.....

IN NAME OF

ALSEA VALLEY FARMS.....

Surveyed May 21 1980, by C. L. Hughes.....