


T. 2 & 3 S., R. 3 W., W. M.

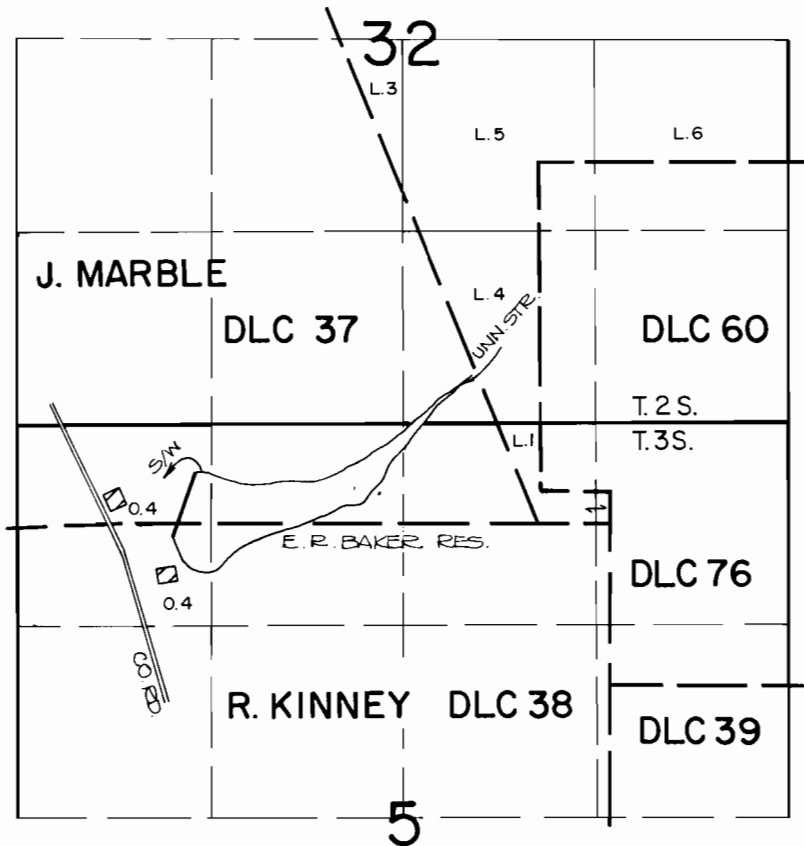

DAM LOCATION: 120 FT. N. AND 2400 FT. W. FROM THE
S. E. CORNER OF THE MARBLE DLC 37.

FINAL PROOF SURVEY UNDER

R-51509 R-6237
Application No. 51510... Permit No. 38823.....
IN NAME OF

.....CAMP TILIKUM.....

Surveyed JUNE 20, 1984, by P. Patten.....



SCALE: 4" = 1 MILE