


T.5S. R.2W. W.M.

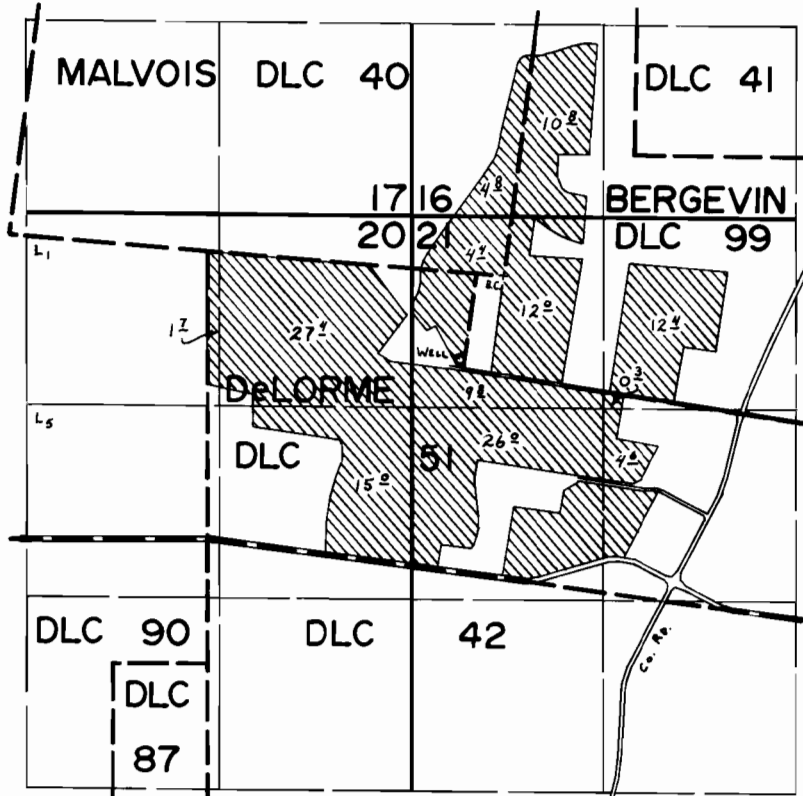

WELL Loc: 570' S. & 300' W. fr. S.E. Cor. Malvois DLC. 40.

FINAL PROOF SURVEY UNDER

Application No. G-6779 Permit No. G-6292....
IN NAME OF

CYRIL & ANITA FERSCHWEILER

Surveyed July 1, 1980, by C.L. Hughes.....