


# T. 10S., R. 1E., W.M.

GEORGE BILYEU DLC 42

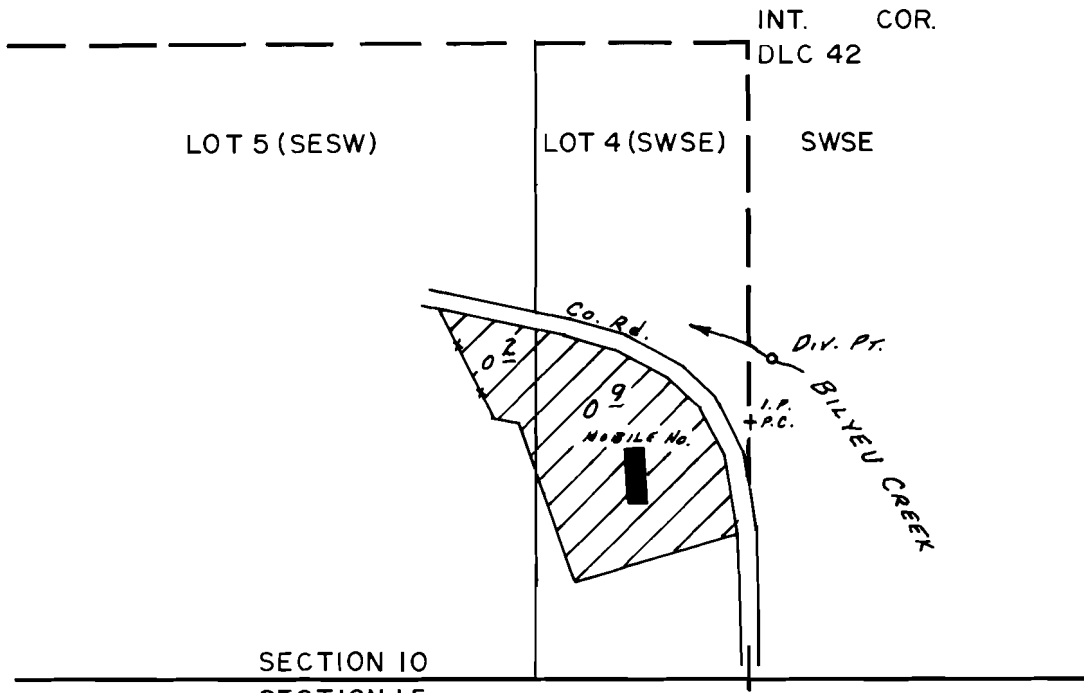

Div. Pt. Loc. 330'S. & 25'E. FROM NE Corner Lot 4

SCALE: 1" = 200'

## FINAL PROOF SURVEY UNDER

Application No. 55722... Permit No. 41735.....  
IN NAME OF

..... DOUGLAS EDWIN FOLTZ .....

Surveyed JULY 7... 1982, by L.M. TOLL.....