


T.7S., R.38E., W.M.

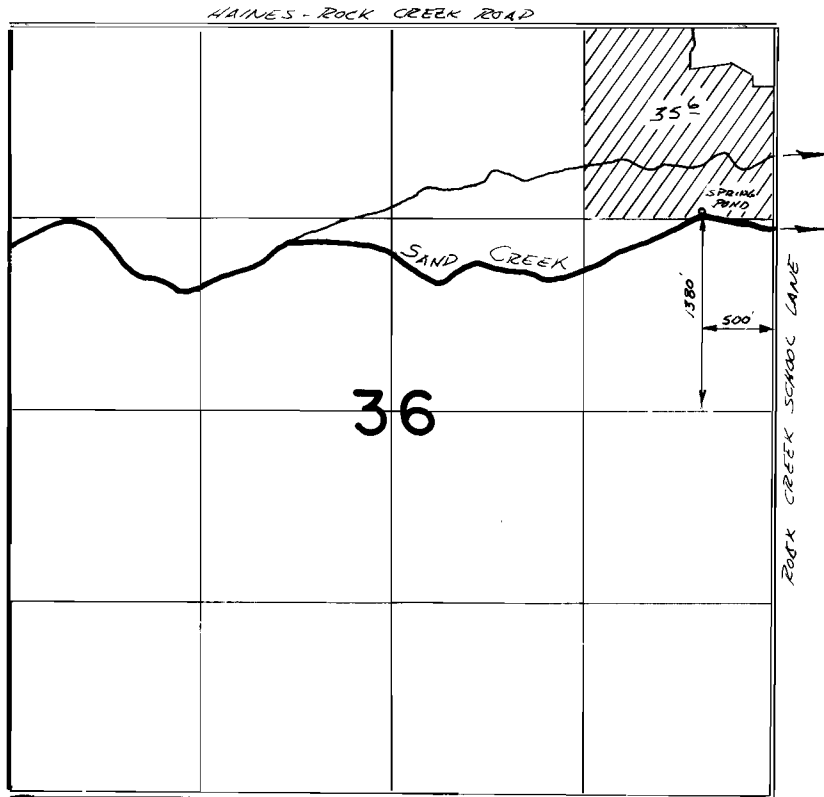

FINAL PROOF SURVEY
UNDER

Application No. 55767.. Permit No. 41759.....
IN NAME OF

.....RONALD E. FROST.....

Surveyed April 12..... 1982., by V.H. Church.....