


T. 39 S., R. 8 W., W. M.

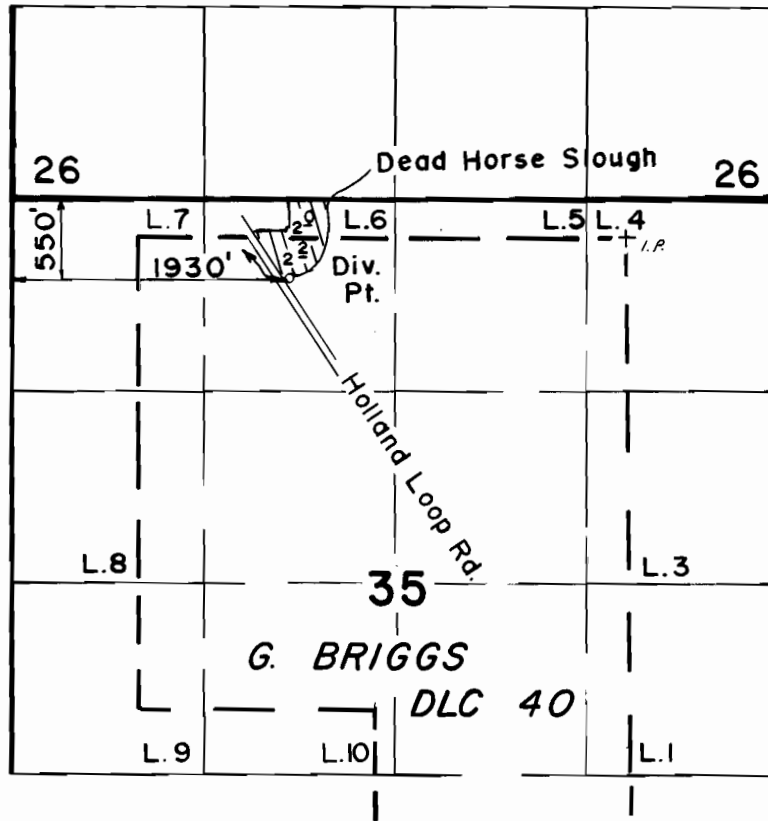

Scale: 1"=1320'

FINAL PROOF SURVEY
UNDER

Application No. **55776** Permit No. **41764**....
IN NAME OF

DONALD A. FULK & MARGARET M. FULK

Surveyed **MAY 13, 1986**, by **B. S. JAMES**.