


T.11S., R.3W., W.M.

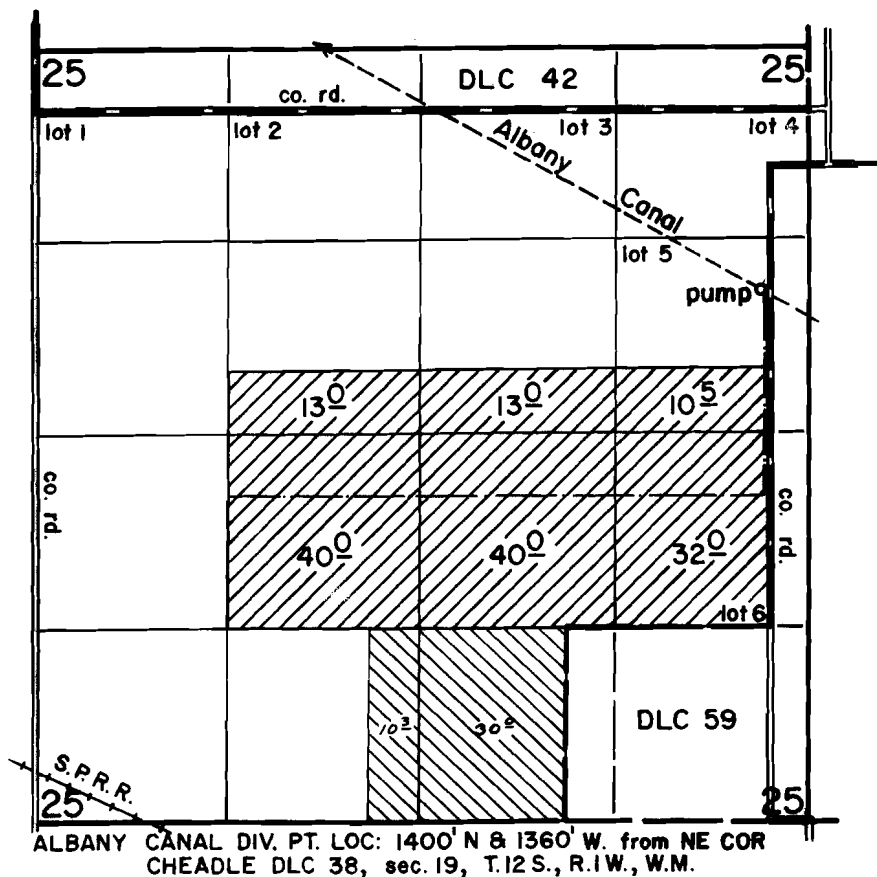

FINAL PROOF SURVEY
UNDER

55894 41922
Application No. 52520 Permit No. 39641
IN NAME OF

INEZ G. GILBERT TRUST

Surveyed Sept. 8 1976, by D. Norby
Aug. 6 1981 by L. TOLL