


T. 37 S., R. 7 W., W.M.

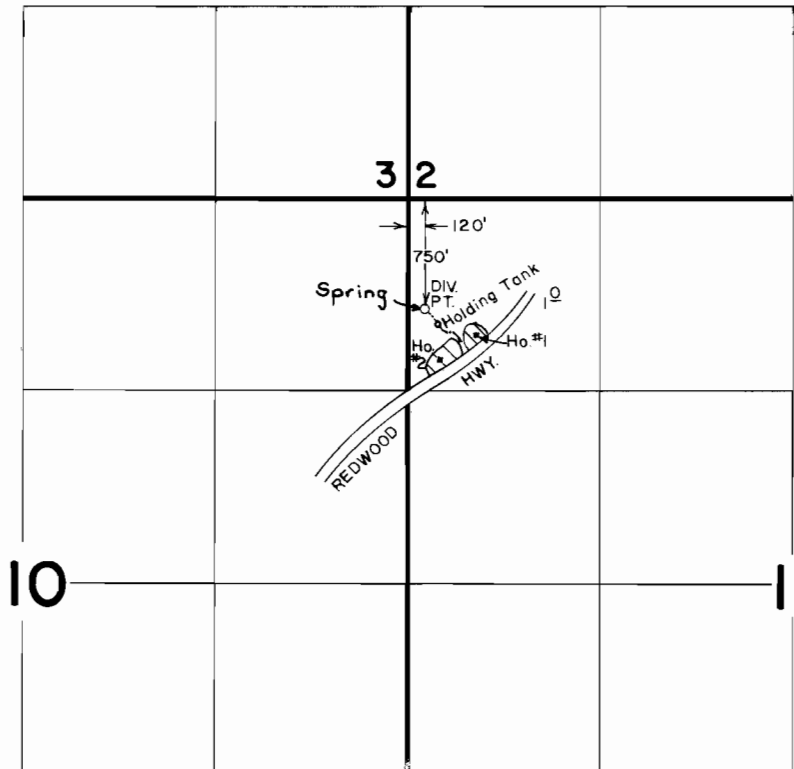

FINAL PROOF SURVEY
UNDER

Application No. 54949 Permit No. 41241
IN NAME OF

DALE S. GREEN

Surveyed OCT. 24 1983, by B. S. JAMES

SCALE: 4" = 1 MILE