


T. 12S., R. 1W., W.M.

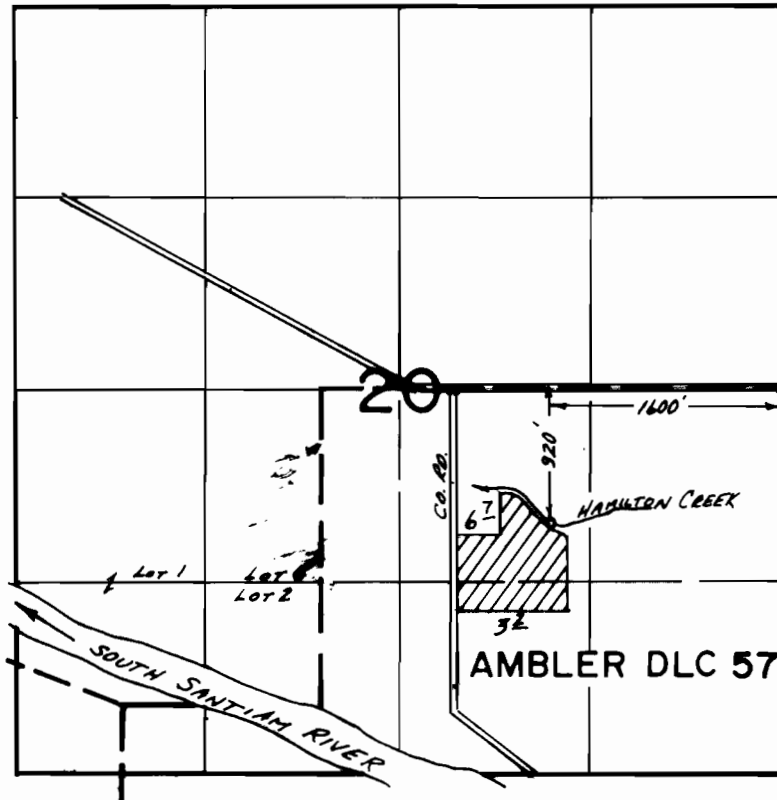

**FINAL PROOF SURVEY**  
UNDER

Application No. 56066.. Permit No. 41951.....

IN NAME OF

..KENNETH & LYDIA J. GREGORY..

Surveyed .APR. 30. 1982., by L. M. TOLL.....