


# T.4S.,R.5W.,W.M.

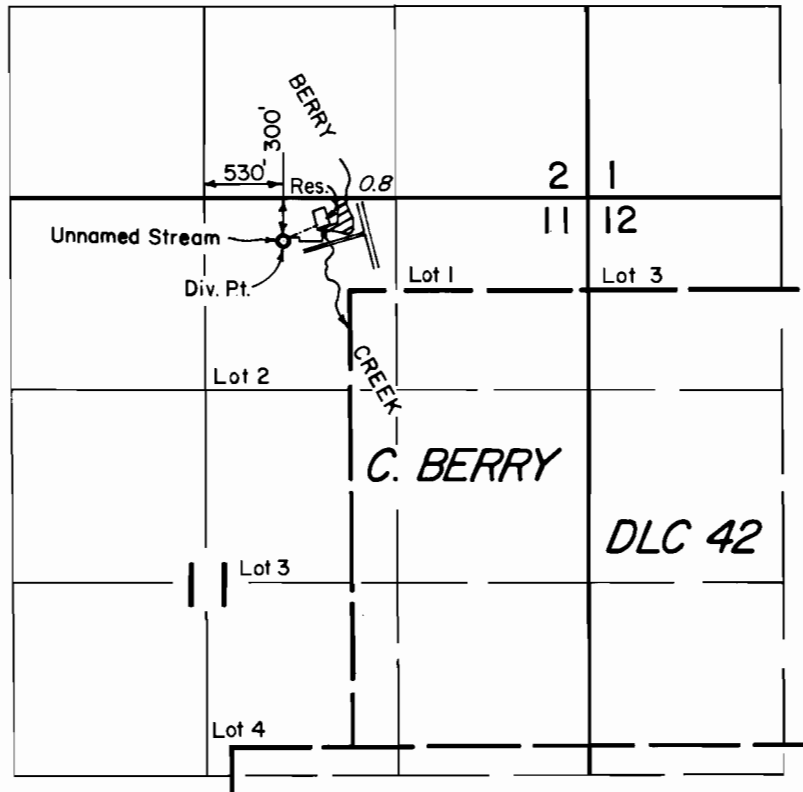

## FINAL PROOF SURVEY UNDER

R-49852      R-6138  
Application No. 49853      Permit No. 37942  
IN NAME OF

KENNETH STANLEY HAGGARD

Surveyed JUNE 3, 1980, by [Signature]