


T.3N.R.1&2W.W.M.

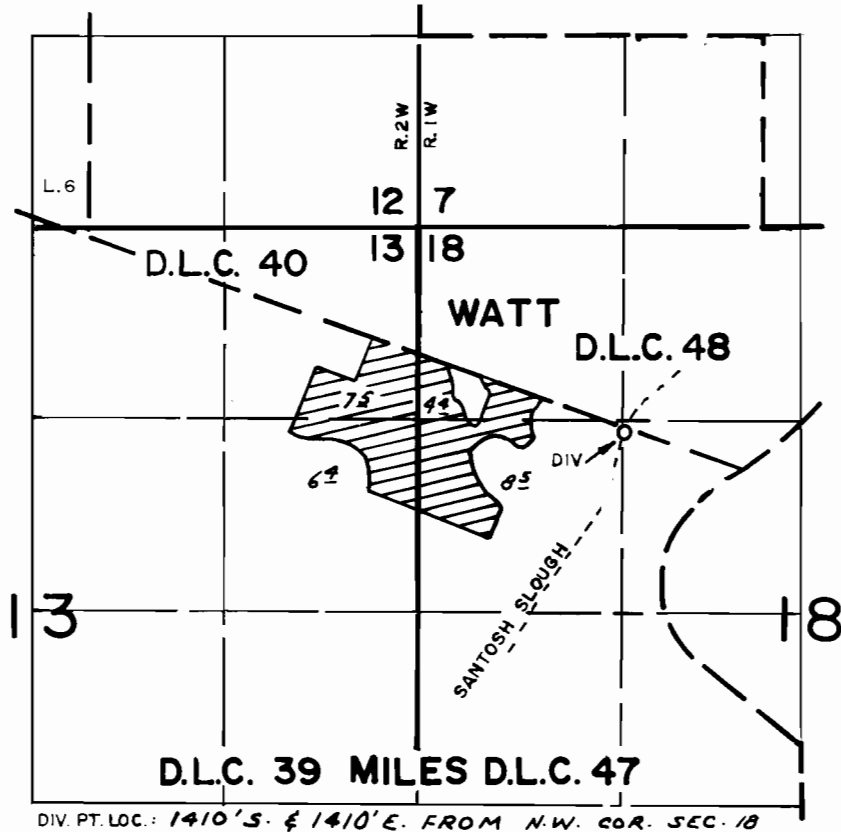

FINAL PROOF SURVEY UNDER

Application No. 52325 Permit No. 37797.....
IN NAME OF

RICHARD EARL HAUGERUD

Surveyed APRIL 7, 1980, by R.G. MUCKEN.....