
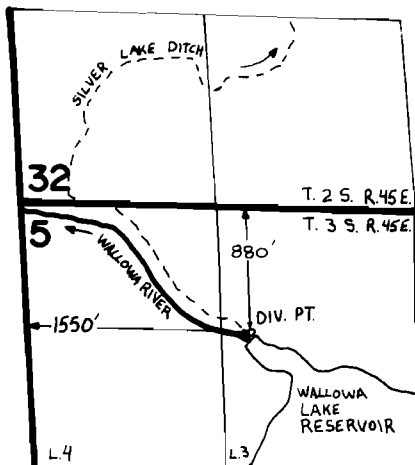
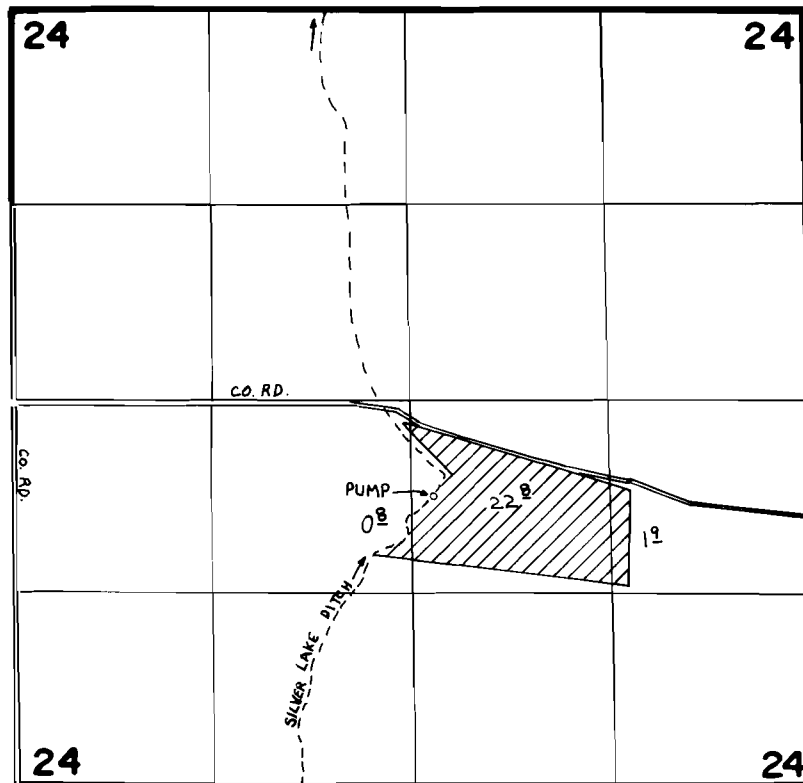


T. 2 S. R. 45 E. W.M.

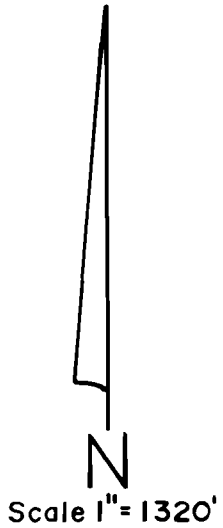

FINAL PROOF SURVEY UNDER

Application No. ~~55682~~ Permit No. ~~41712~~.....
IN NAME OF

DONALD L. HOUGH.....

Surveyed Aug...15... 1985., by .V.Church.....