


T. 1 S. R. 8 W. W. M.

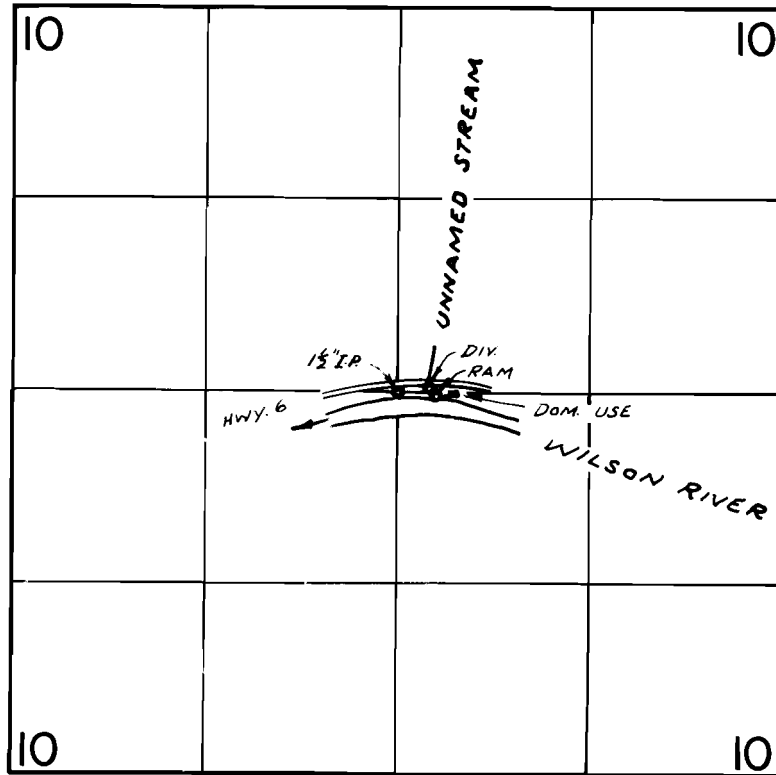

DIV. PT. LOC: 20' N. & 200' E. FROM CEN. SEC. 10

FINAL PROOF SURVEY UNDER

Application No. 53459 Permit No. 40449
IN NAME OF

STEVE J. HUGHSON

Surveyed FEB. 12, 1980, by R.G. MURKEN