


T.11S., R.2W., W.M.

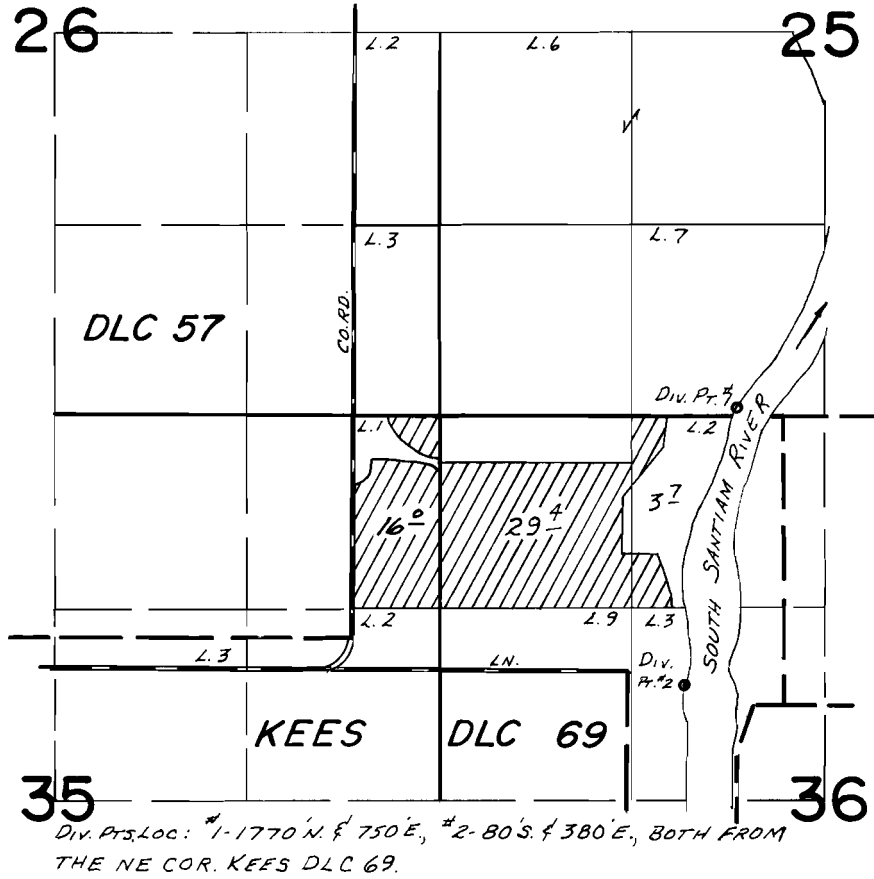

FINAL PROOF SURVEY UNDER

Application No. 55277... Permit No. 41424.....
IN NAME OF

.....CLAIR HULL.....

Surveyed MAY 26.. 19.82, by L.M.TOLL.....