


T. 3 S., R. 9 W., W.M.

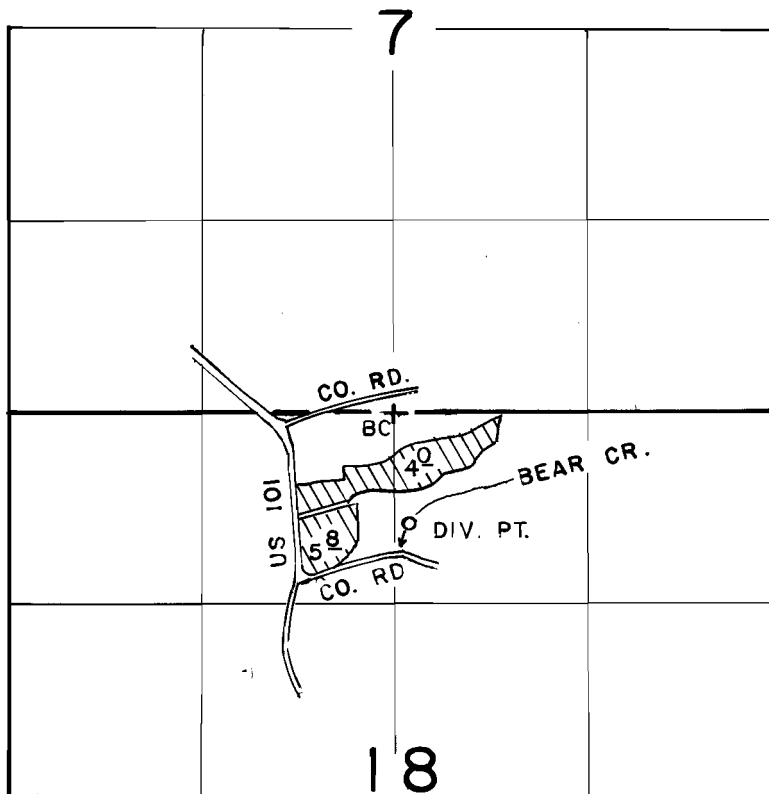

SCALE
1" = 1320'

DIV. PT. LOC. 770' S. & 100' E. OF N1/4 COR. SEC. 18

FINAL PROOF SURVEY UNDER

Application No. 55245 Permit No. 41471
IN NAME OF

HOWARD KALIHHER, M.D.

Surveyed AUG 2 1984, by P. PAGTER