


T. 26 S., R. 4 W., W.M.

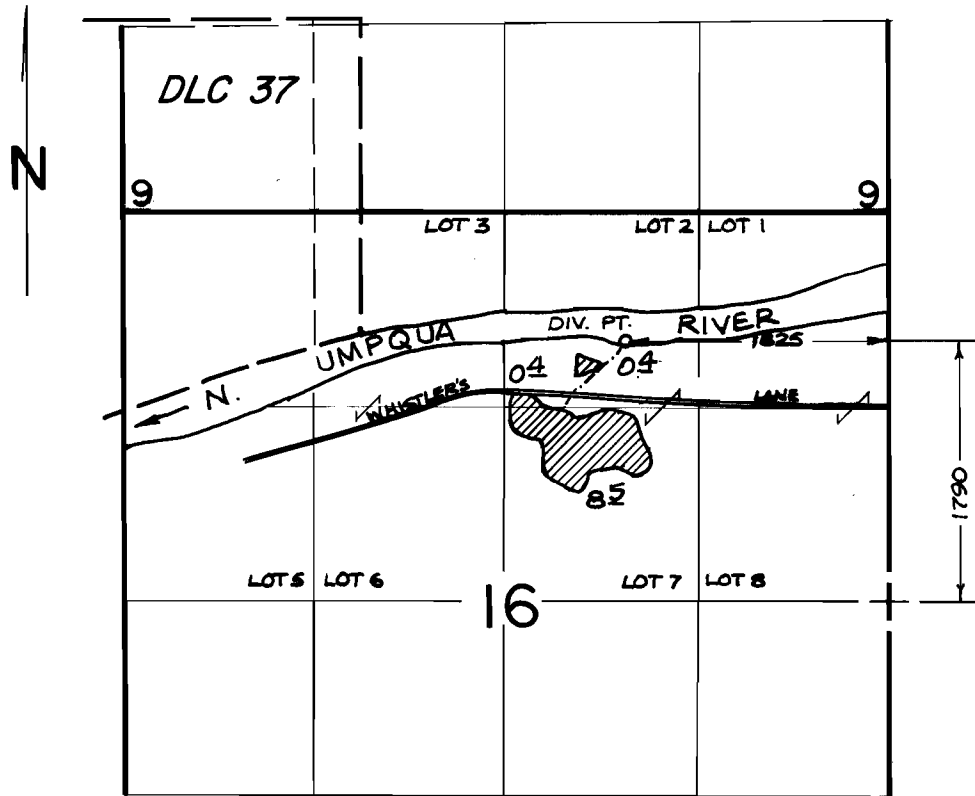

SCALE : 4" = 1 MILE

FINAL PROOF SURVEY

UNDER

Application No. ..67956.. Permit No.48305....
IN NAME OF

ROBERT...P...KIDDER...AND...JULIA...W...KIDDER

Surveyed ..SEPT...3, 19.86., byJ.M..SCHMORDE