


T. 4N., R. 35 & 36E., W.M.

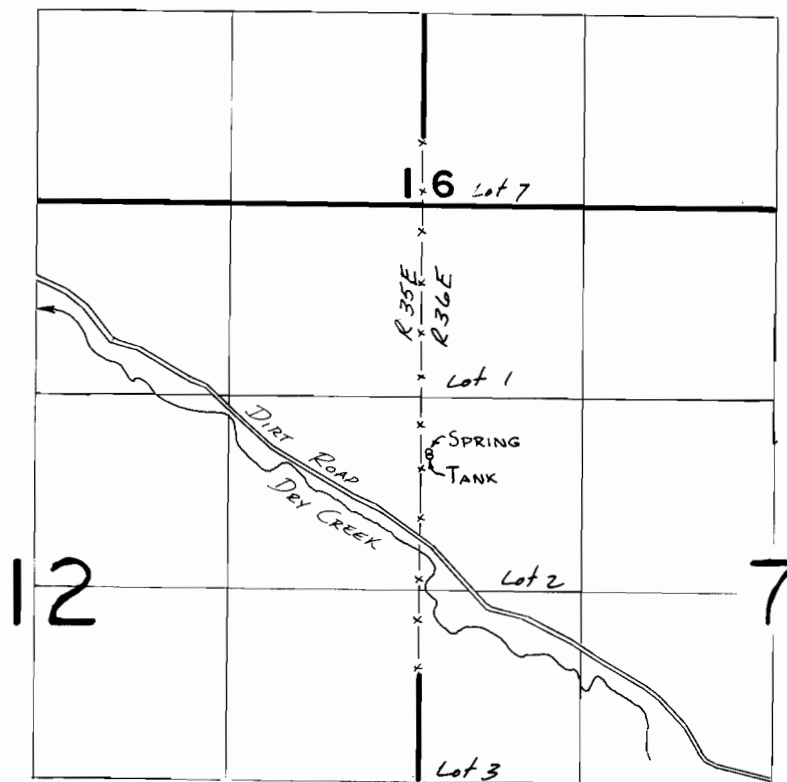

SPRING Loc: 950'N. & 50'E. FROM W 1/4 COR. SEC. 7

FINAL PROOF SURVEY UNDER

Application No. **55413** Permit No. **41811**.....
IN NAME OF

FRANK BUELL.....

Surveyed **3-2**..... 19**87**., by **V.L. Church**.....