



T. 23 S., R. 33 E., W.M.

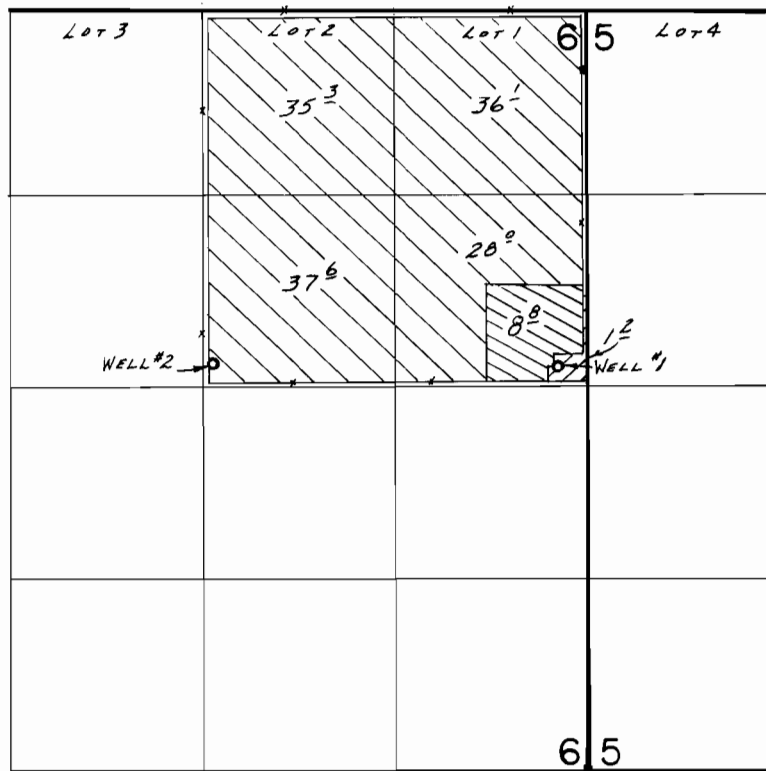

SCALE: 1" = 1320'

WELLS LOC.: #1- 140' N. & 2430' E., #2- 160' N. & 60' E., BOTH FROM THE CENTER 1/4 CORNER OF SECTION 6.

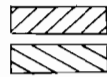

WELL 1 } PER. G-6674
WELL 2 } PER. G-7919

FINAL PROOF SURVEY

UNDER

Application No. G-6838 G-6674
G-8565. Permit No. G-7919.....
IN NAME OF

CLAY FOX

Surveyed JULY 15, 1986, by V.L. CHURCH.....

12/17/87 BWS
41025-179-34R