



T.32 & 33S., R.2 & 3E., W.M.

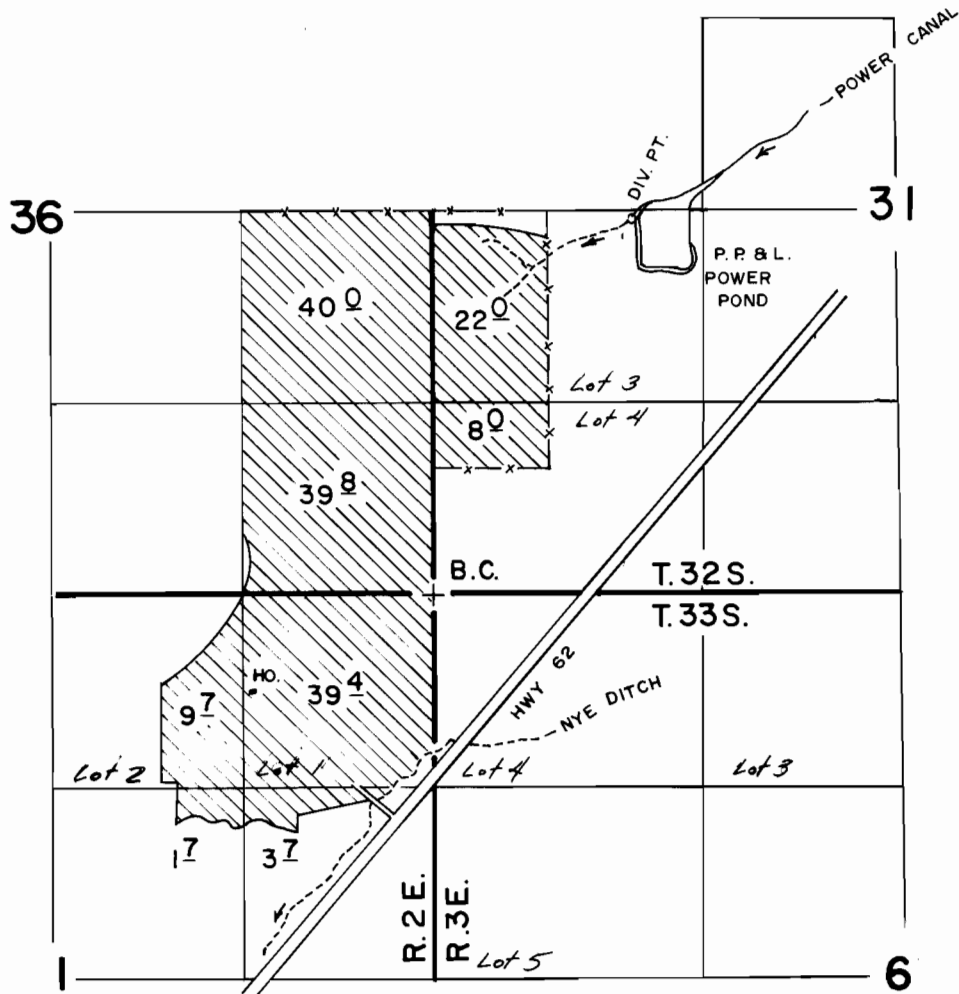

SCALE 4" = 1 MILE

Sec. 29

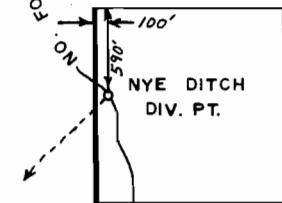

NW 1/4 SW 1/4
T. 32 S., R. 3 E., W.M.

FINAL PROOF SURVEY UNDER

62062 46021
Application No. 50108... Permit No. 37415.....
IN NAME OF

.....RALPH & or ANNABELLE LEIBY

Surveyed May..23, 1983, by B.S. JAMES.....