


T.6S.,R.4W.,W.M.

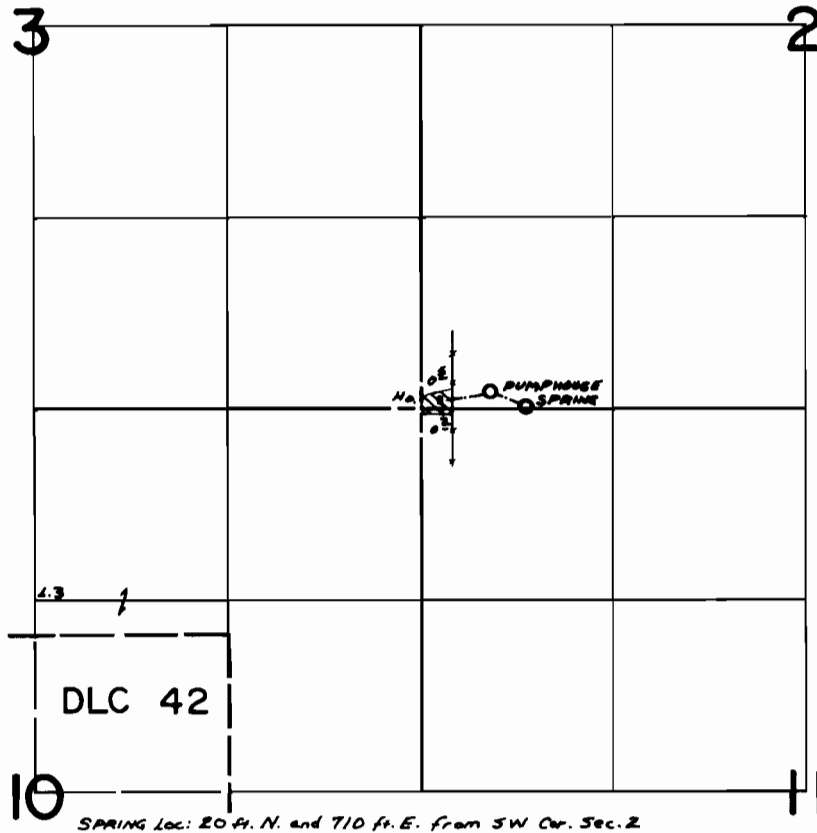

FINAL PROOF SURVEY
UNDER

Application No. 56100.. Permit No. 41998.....
IN NAME OF

.....DAVID LENHARDT.....

Surveyed Nov..12.. 19.81., by ..L..TOLL.....