


# T.7S.,R.46E.,W.M.

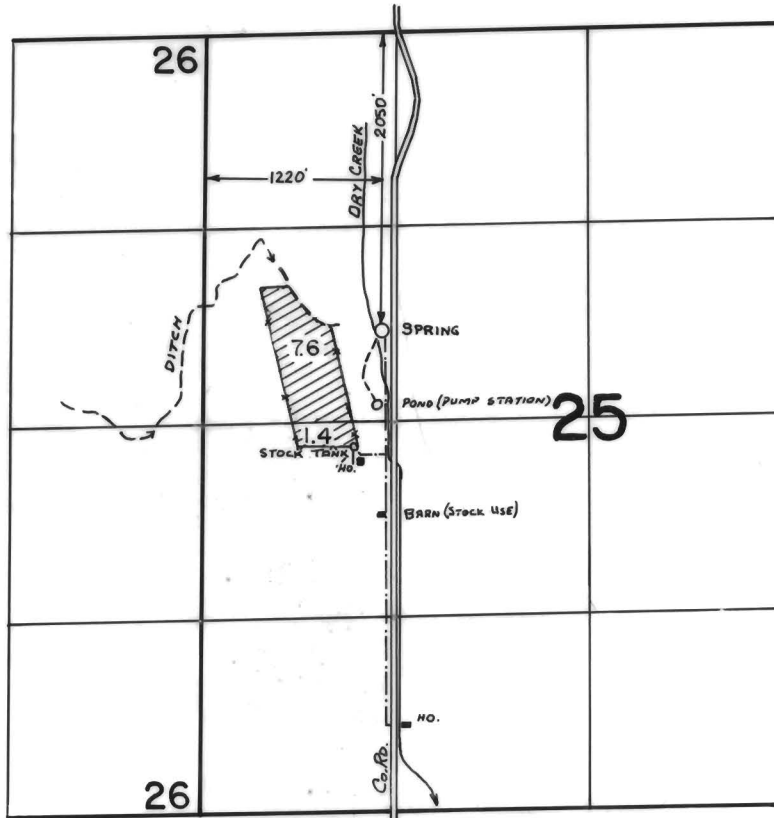

SCALE: 1" = 1320'

## FINAL PROOF SURVEY UNDER

Application No. 59432 Permit No. 44752  
IN NAME OF

DONALD B. MARTIN

Surveyed Aug. 26, 1985, by L. M. TOLL