


T.12S.,R.6W.,W.M.

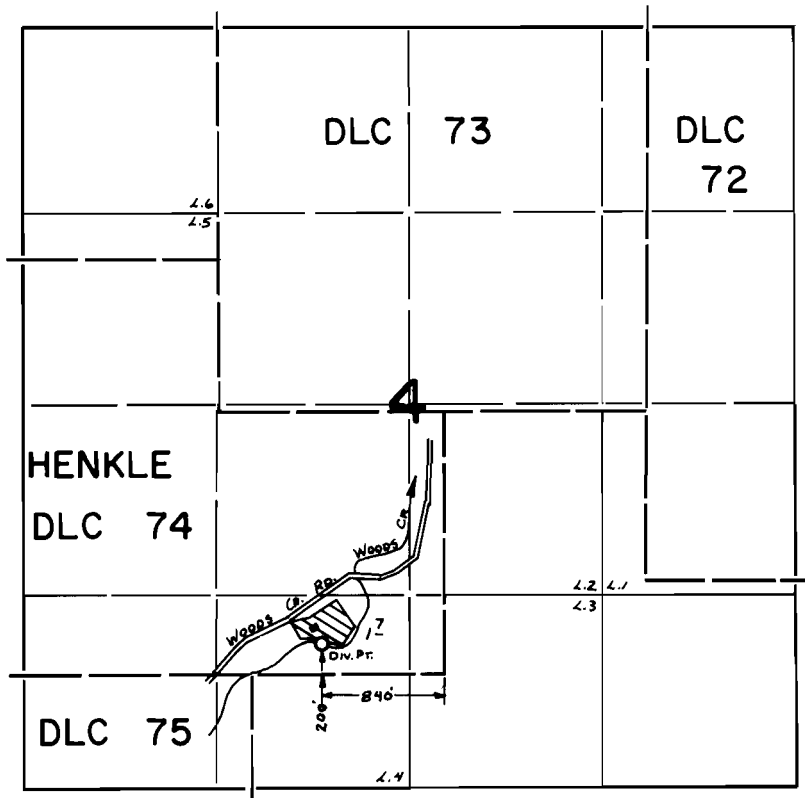

FINAL PROOF SURVEY UNDER

Application No. .56046. Permit No. ...41947.....
IN NAME OF

JERALD...D...&...EVELYN...MCCONNELL

Surveyed .Sept...10... 1982., by .L..M..TOLL.....