


T. 37 S., R. 7 & 8 W., W. M.

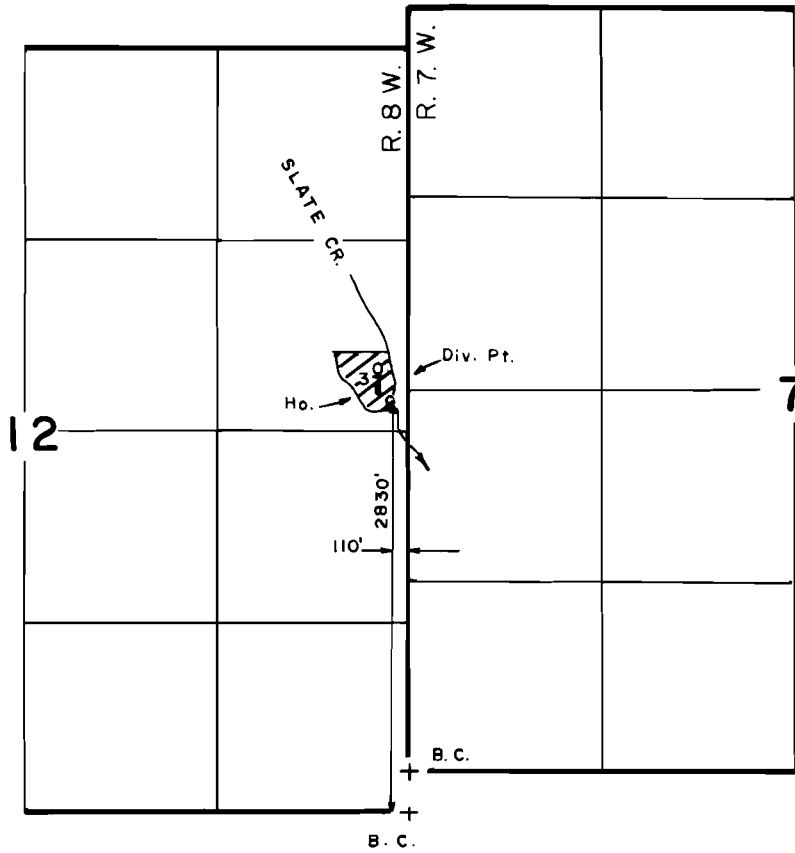

Scale: 1" = 1320'

FINAL PROOF SURVEY
UNDER

Application No. **54404** Permit No. **40800**
IN NAME OF

JETTE MC HENRY

Surveyed **JUL 14 1986**, by **B.S. JAMES**