


T. 40S., R. 8W., W.M.

Handwritten notes:
19
30

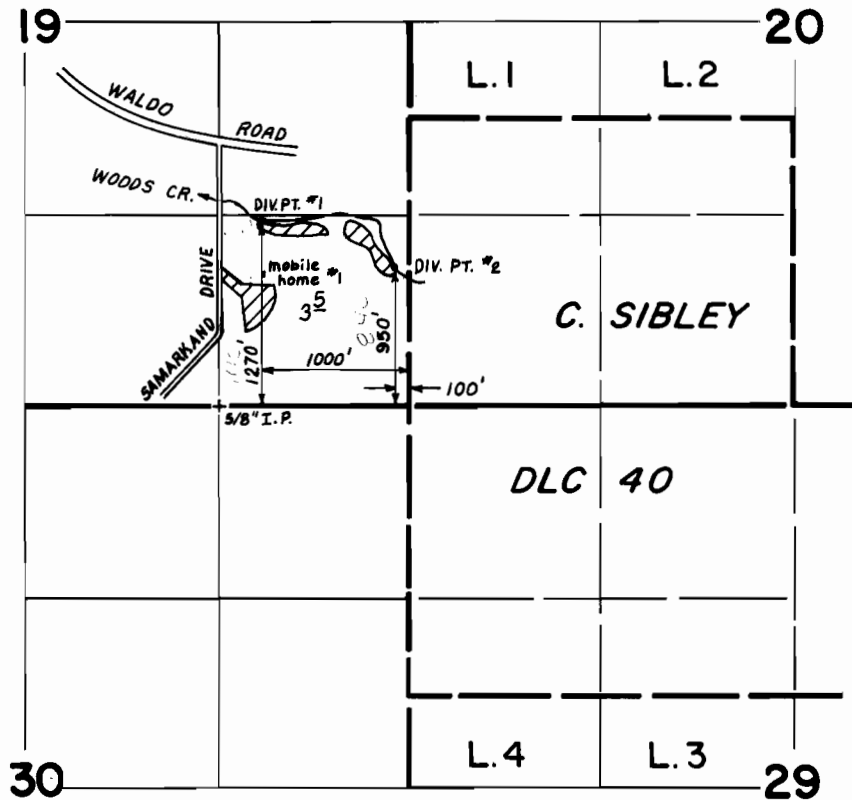

Scale: 4" = 1 mile

FINAL PROOF SURVEY UNDER

Application No. 55766 Permit No. 41758
IN NAME OF

G. EDWARD MICHELS

Surveyed MAR. 26 19 84 by B. S. JAMES