


P-41906
57801

T.13S., R.30E., W.M.

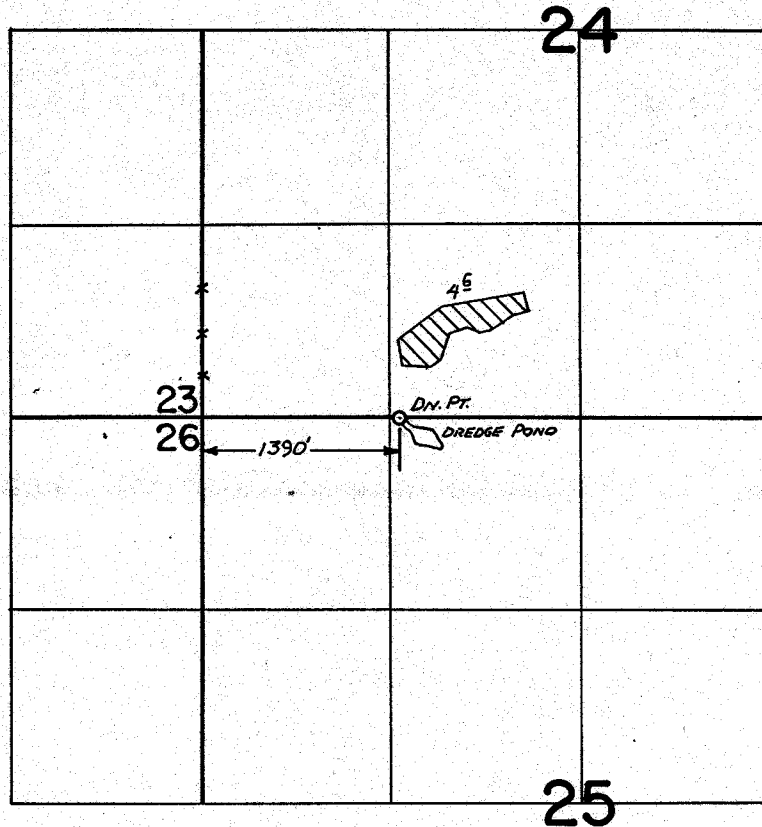

FINAL PROOF SURVEY
UNDER

Application No. 55865.. Permit No. 41906.....

IN NAME OF

MAX MOERY

Surveyed Aug. 25... 19.83., by R.W. Cattel.....