


T. 1 S.,
R. 45 E.,
W. M.

SCALE: 1" = 1320'

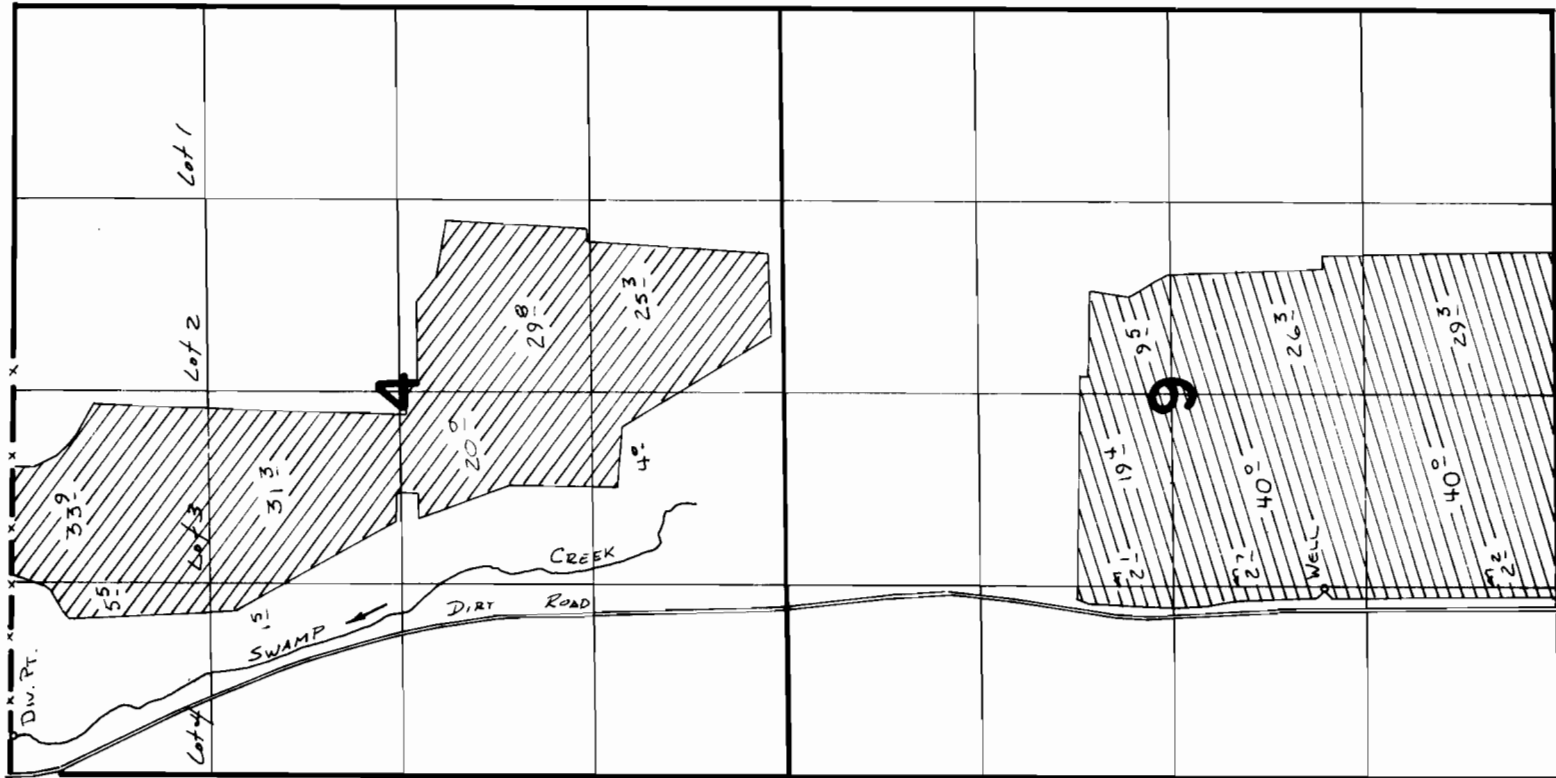

WELL LOCATED 1600' N. & 1320' E. FROM SW COR. SEC 9
DIV. PT. LOCATED 10' S & 250' E. FROM NW COR. SEC 4

FINAL PROOF SURVEY UNDER

54611 40976
Application No. G-9417 Permit No. G-8768
IN NAME OF

FAY & GERTRUDE OLSEN

Surveyed 8-12 1985, by V. b. Church

