


T. 1 S.,
R. 45 E.,
W. M.

SCALE: 1" = 1320'

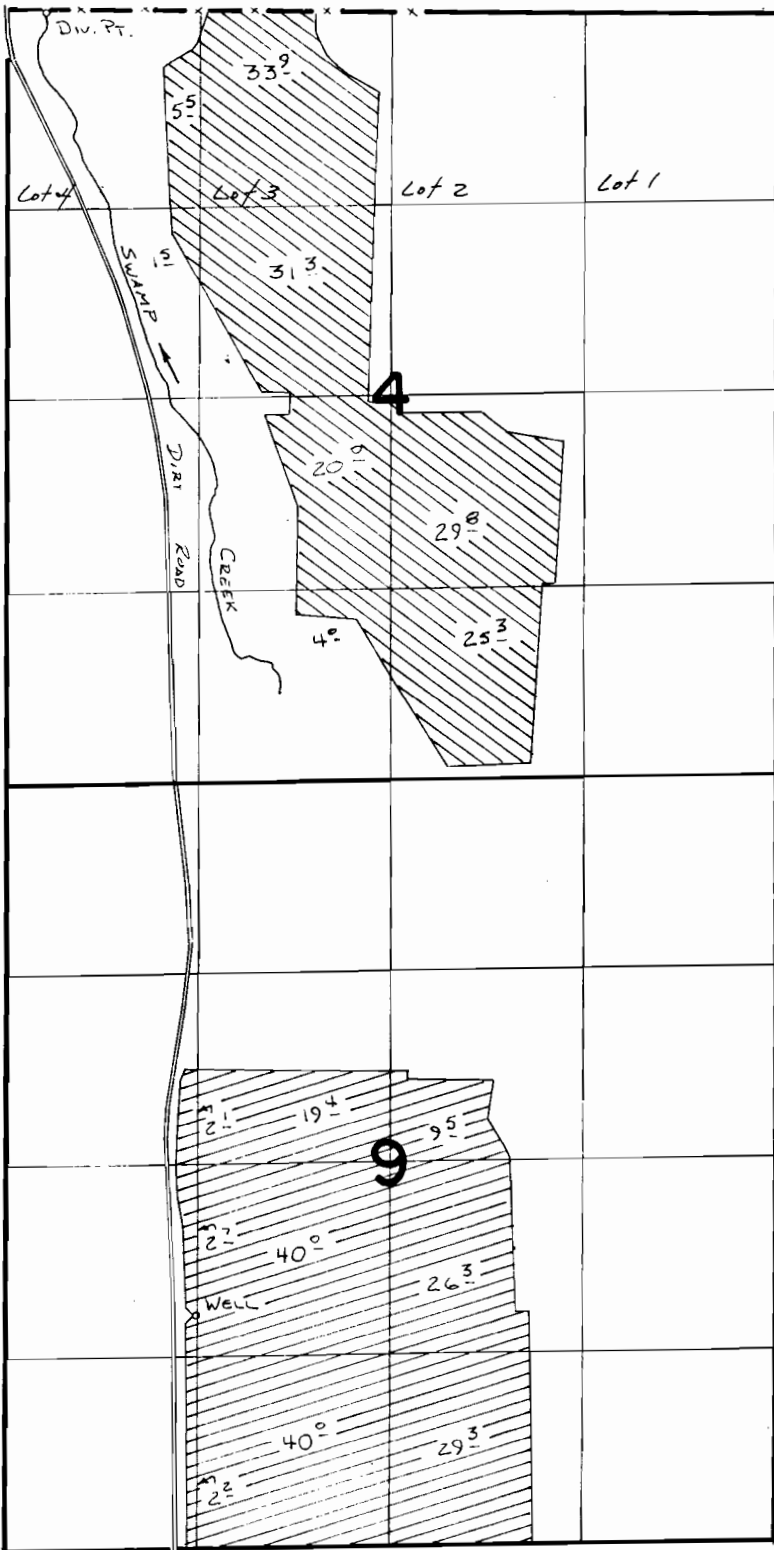

Well located 1600' N. & 1320' E. From SW Cor. Sec 9
Div. Pt. located 10' S & 250' E. From NW Cor. Sec 4

FINAL PROOF SURVEY UNDER

54611

40976-

Application No. G:9417. Permit No. G:8768.
IN NAME OF



FAY & GERTRUDE OLSEN

Surveyed 8.11.1935, by W. B. Church