


T. 7 S., R. 6 W., W.M.

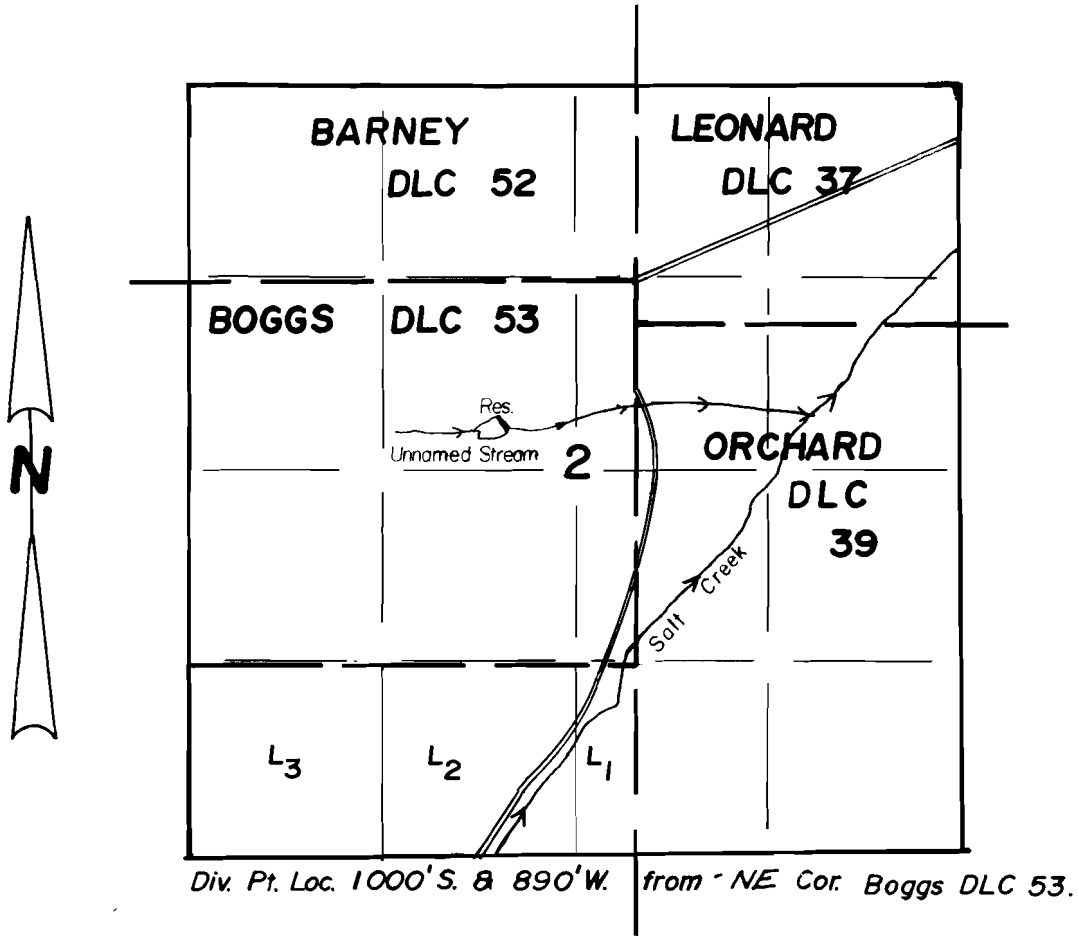

Scale : 1" = 1320'

FINAL PROOF SURVEY

UNDER

Application No. **5467** Permit No. **40914**
~~R-5466~~ ~~R-6527~~

IN NAME OF

STEVAN JEPSEN & DOROTHY BYNUM

Surveyed **AUG. 11**, 1983, by **L. TOLL**