


T.29S., R.5W., W.M.

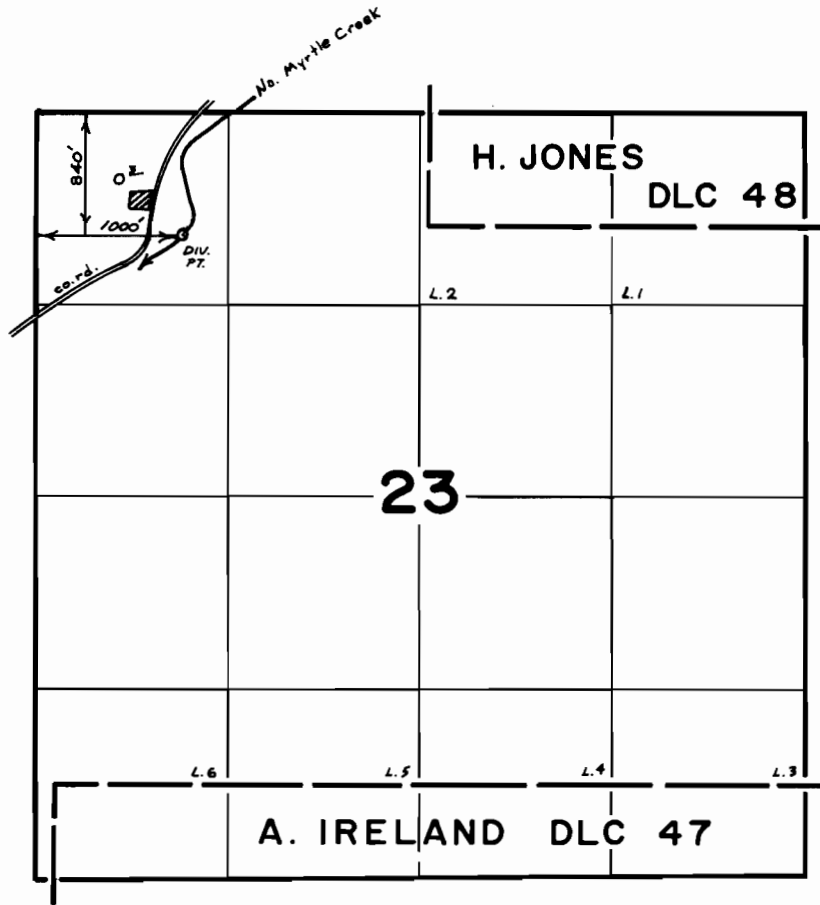

SCALE 4"=1 mile

FINAL PROOF SURVEY UNDER

Application No. 57919.. Permit No. 43687....
IN NAME OF

.....ADELINE.....NEWZELL.....

Surveyed March 1, 1979, by S. Donaldson....