


# T. 39 S., R. 8 W., W.M.

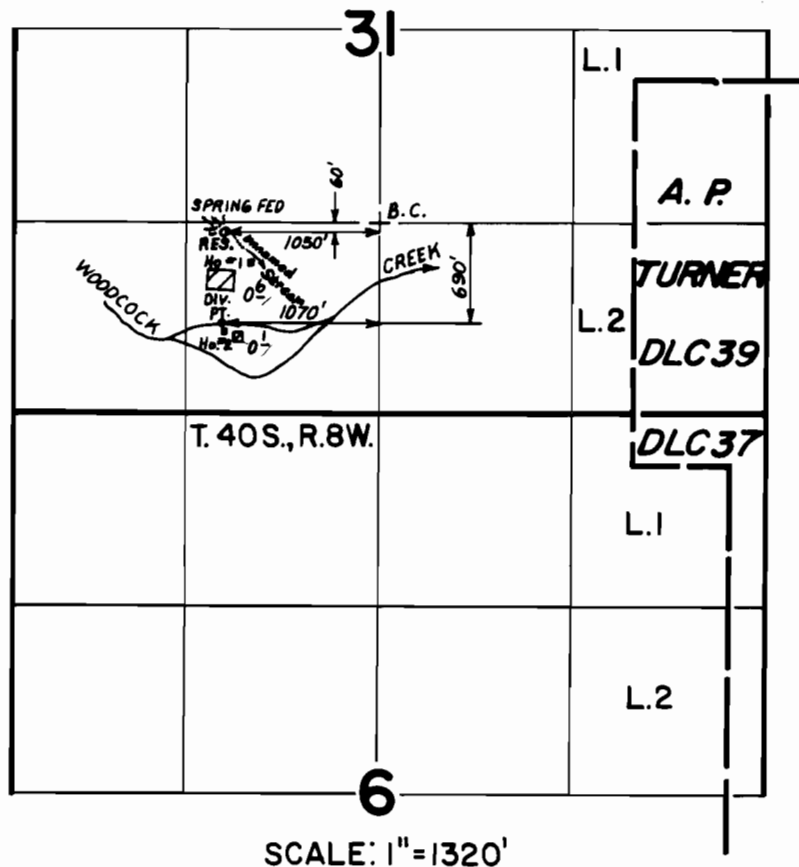

## FINAL PROOF SURVEY UNDER

R-54587      R-6525  
Application No. ~~54588~~ Permit No. ~~40912~~....  
IN NAME OF

ROBERT L. & JELENE H. WILSON.....

Surveyed MAR. 28. 19.84, by B. S. JAMES.....