


# T. 39 S., R. 8 W., W.M.

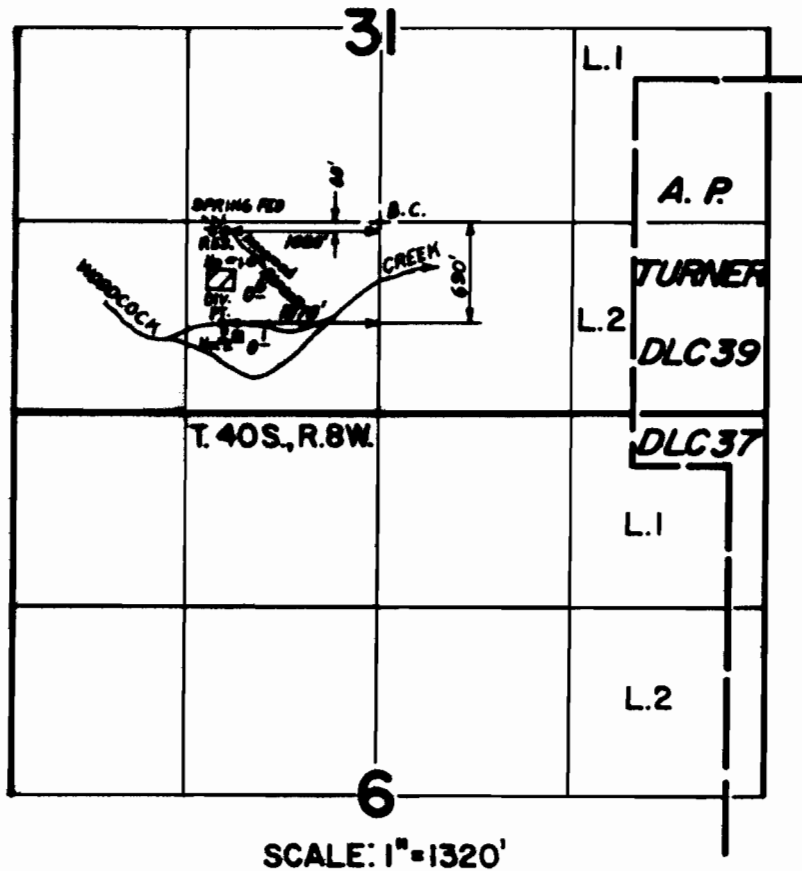

## FINAL PROOF SURVEY UNDER

R-54587      R-6525  
Application No. **54588** Permit No. **40912**....  
IN NAME OF

**ROBERT L. & ILENE H. WILSON**....

Surveyed **MAR. 28. 1984**, by **B.S. JAMES**....