


T. 38 S. R. 6 W., W. M.

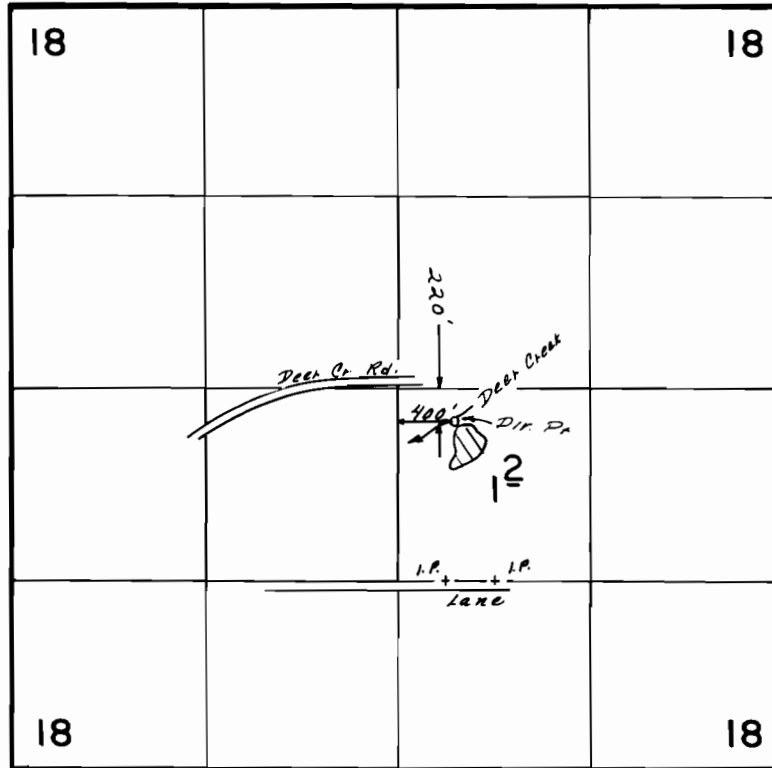

Scale: 1" = 1320'

FINAL PROOF SURVEY
UNDER

Application No. **54839** Permit No. **41138...**
IN NAME OF

.....**GEORGE W. OWENS**.....

Surveyed **JUN...5...** 19**86**, by **B...S.....JAMES.**