


T.13S.,R.10W.,W.M.

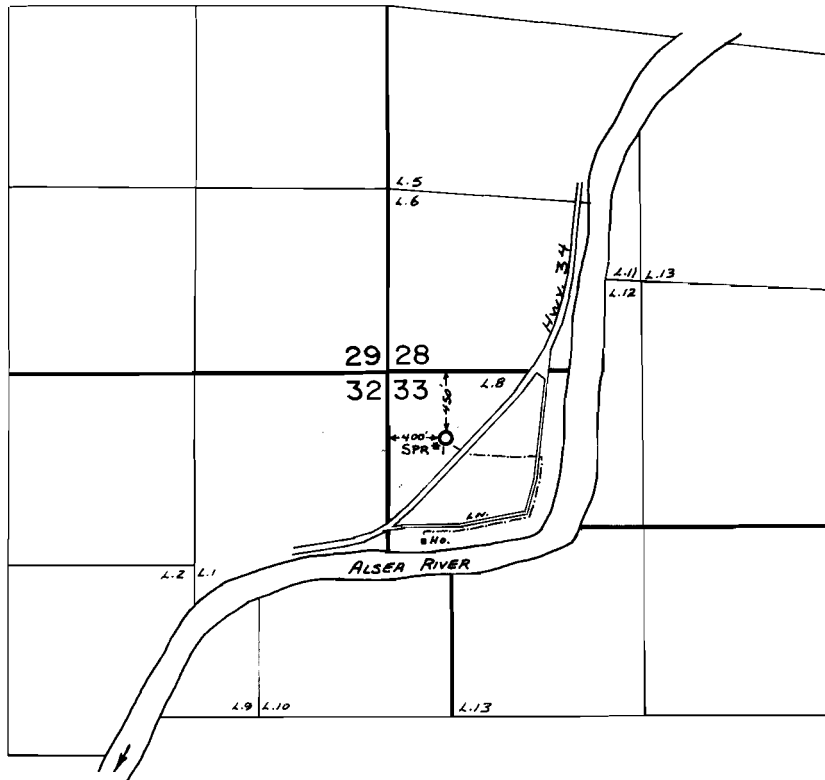

FINAL PROOF SURVEY UNDER

Application No. 55342. Permit No. 41494.....
IN NAME OF

.....WENDELL H. PALMER.....

Surveyed Oct. 21... 1981., by S.C. BROWN.....