


T.11S. R.2W. W.M.

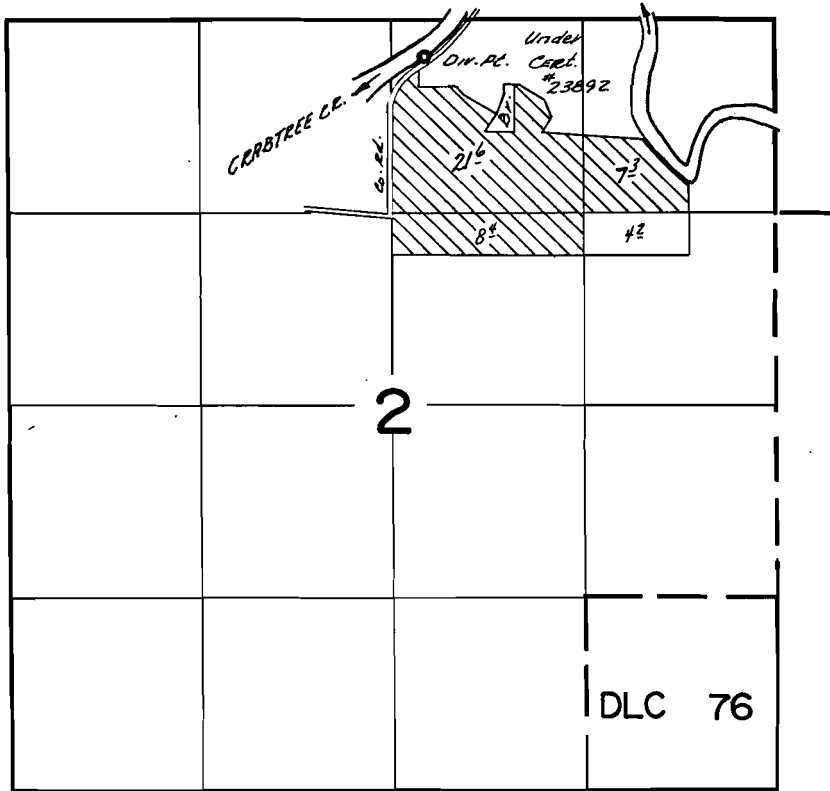

Div. Pl. Loc. ~ 258' S & 210' E from N 1/4 Cor. Sec. 2

FINAL PROOF SURVEY

UNDER

Application No. 53764. Permit No. 40372.....
IN NAME OF

DAVID R. & PATRICIA P. PAPE.....

Surveyed July.....2.. 1979., by S.C. BROWN.....