


T.29S., R.5W., W.M.

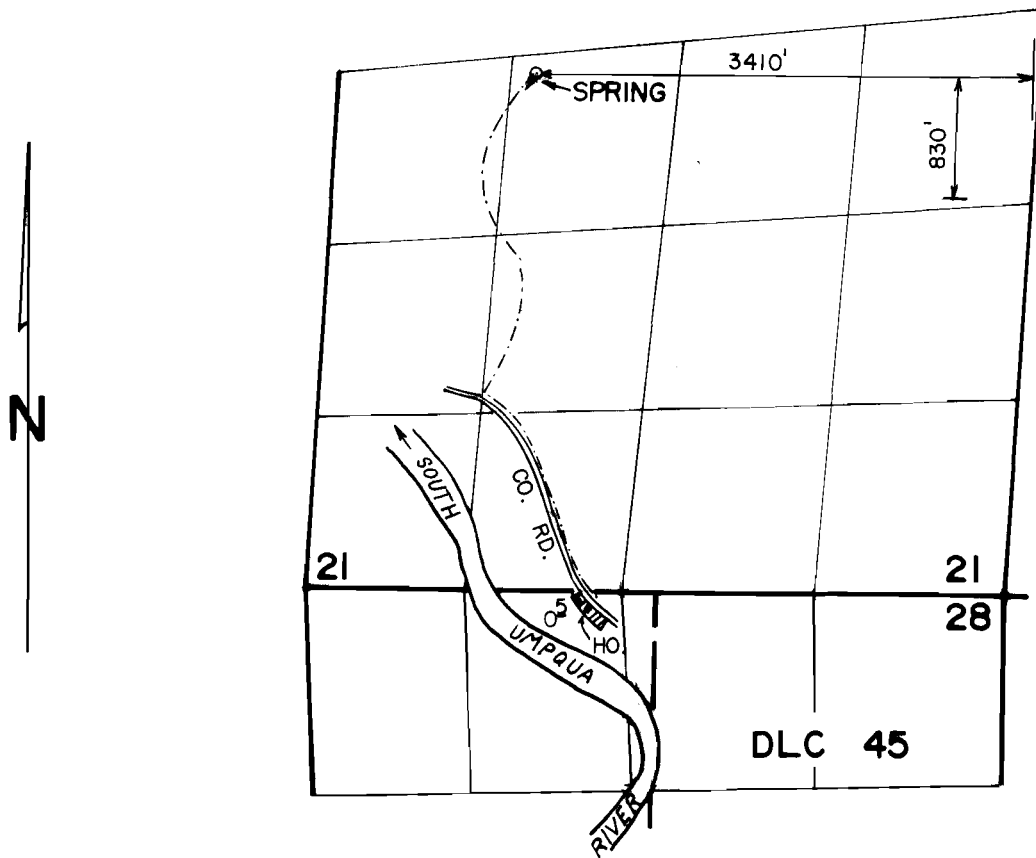

SCALE: 4" = 1 mile

FINAL PROOF SURVEY
UNDER

Application No. 55883. Permit No. 41916.....
IN NAME OF

WARREN H. & ANNA P. POLAND

Surveyed MAY 21, 1984, by *L.E. Cashion*