


T.12S.,R.33E.,W.M.

SECTION 35

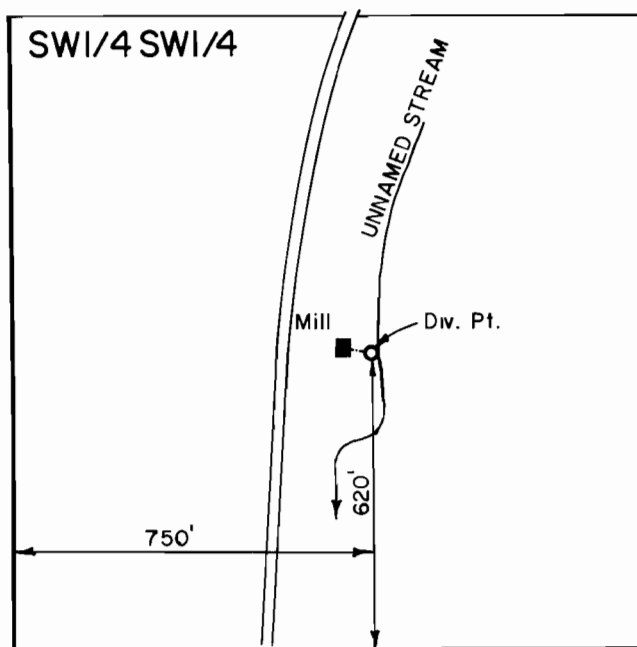

SCALE 1" = 400'

FINAL PROOF SURVEY
UNDER

Application No. 55835 Permit No. 41892
IN NAME OF

Prairie City Shake & Shingle, Inc.

Surveyed AUG. 27, 1981, by J. B. Brown